

**SHARKEY MISSISSIPPI BOARD OF WATER COMMISSIONERS**

JZ4  
2-12-64

**WATER WELL DRILLERS LOG**

**CODED**

Date: 2/12, 1964, Driller: Frank Riley County: Blount  
(Name)

(1) Owner of Land: Francis Riley  
(Name)  
Blanton Jones  
(Address)  
(2) Location: 1/4, 1/4, Sec. 11 T10R7,  
3 miles East of Blanton,  
(distance) (direction) (Nearest Town)  
(3) Topography: A  
(Hilly) (Flat) (Level)  
(4) Purpose of Well: Home  
(Domestic Irrigation  
Municipal, Industrial, Other)


Description & Color of Materials Sand, Clay, Red Clay, Shell, etc.	Thick- ness Feet	Depth Feet
Clay	0	18
Fine sand		40
sand + Red gravel		140
Red gravel + block		170
Brown Clay		320
Shale + Silt Rock		344
Shaly Silt sand + block		450
Fine sand		472
sand + shale		492
sand + silt shale		510
Shaly + Silt Rock		658
Shale	658	804
sand + shale		846
Fine sand		947

**Information upon completion of well:**

(1) Diameter 2x4 inches.  
(2) Total Depth 947 feet.  
(3) Water Level Flushing feet below top of ground.  
(4) Cased to 947, Size 8 1/2" x 2 1/2",  
(5) Screen: Size 3" O.D., Length 20ft.  
(6) Were any formations sealed against pollution?  
\_\_\_\_\_ yes, X no.

**CODED**

If YES depth of formation \_\_\_\_\_  
Why \_\_\_\_\_  
Drillers Remarks: \_\_\_\_\_

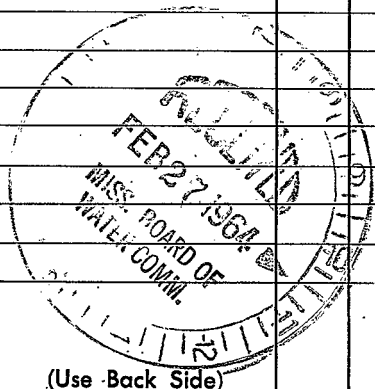

(Use Back Side)

Well No.




