Simpson
B17
9-72

MISSISSIPPI
BOARD OF WATER COMMISSIONERS
416 North State Street
Jackson, Mississippi 39201

CODED

WATER WELL DRILLERS LOG

Sept. 1972 — R. E. Thompson — Simpson
date well completed — firm name — county well located

LANDOWNER: Lin Weatherby
Brookhaven Miss.
(mailing address)

WELL LOCATION:
sec. 14 T 2 (N/S) R 2 (E/W)
6 miles W of Brookhaven
(distance) (direction) (nearest town)

WELL PURPOSE: Home
(home, irrigation, municipal, industrial)

WELL COMPLETION DATA:

(1) diameter (inches) 2"
(2) total depth (feet) 253
(3) static water level (feet) 78' below ~~above~~ top of ground.
(4) casing Plastic (material), 240' (depth), 2" (size) If telescope see back.
(5) screen 10' (length), 240 (depth to top), .008 (size), Plastic (material)
(6) pump 2 (HP) 8 (yield gpm)
Jet. (type power)
(7) electric log No (yes or no)
(organization running log)
(8) how well bottom plugged Open

DRILLERS REMARKS:

description of formations encountered	from	to
Top Soil	0	5
Sandy	5	30
Blue clay	30	230
Sand	230	250
Blue clay	250	253

CODED

MISS.

If well telescopes please sketch and show depths.

GROUND LEVEL

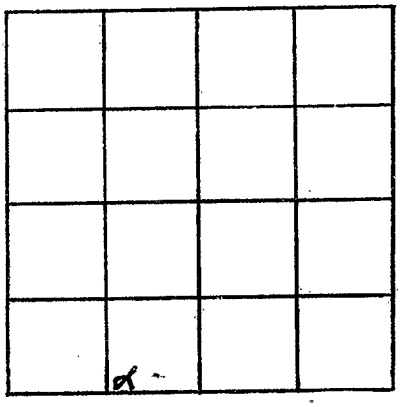

SECTION 14

Please indicate well location X.

ADDITIONAL INFORMATION

If more than one screen, show locations of each on sketch.