Simpson
C 33
10-20-71

ELOG # 153

MISSISSIPPI
BOARD OF WATER COMMISSIONERS
416 North State Street
Jackson, Mississippi 39201

CODED

WATER WELL DRILLERS LOG

10-20 1971 K. E. Thompson Simpson
date well completed firm name county well located

LANDOWNER: Carlton Mooney.
D'Lo. Miss.
(mailing address)

WELL LOCATION:
sec. 23 T 2 N/S R 3 E/W
1 1/2 miles S of Brookton
(distance) (direction) (nearest town)

WELL PURPOSE: Home
(home, irrigation, municipal, industrial)

WELL COMPLETION DATA:

(1) diameter (inches) 2"
(2) total depth (feet) 280'
(3) static water level (feet) 68 below ~~above~~ top of ground.
(4) casing Plastic 254'
(material) (depth)
2" If telescope see back.
(size)
(5) screen 10' 254'
(length) (depth to top)
008 Plastic
(size) (material)
(6) pump 1 1/2 10
(HP) (yield gpm)
Auto.
(type power)
(7) electric log yes
(yes or no)
M. G. S.
(organization running log)
(8) how well bottom plugged Bridge

DRILLERS REMARKS:

description of formations encountered	from	to
top soil	0	5
Sandy clay	5	40
Red clay	40	200
Sand	200	220
Clay	220	240
Sand	240	264
Red clay & sand	264	280

CODED

NOV 3 - 1971
MISS. BD. OF WATER COMM.

If well telescopes please sketch and show depths.

GROUND LEVEL

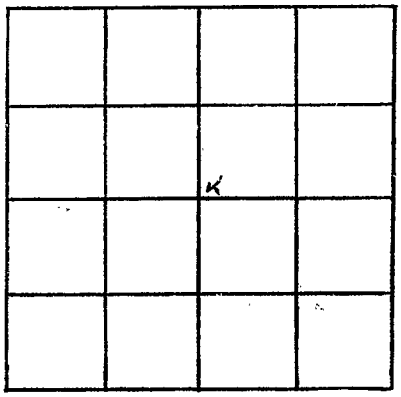

SECTION 23

Please indicate well location X.

ADDITIONAL INFORMATION

If more than one screen, show locations of each on sketch.