Simpson
C51
8-4-78
Elog #219

# MISSISSIPPI
# BOARD OF WATER COMMISSIONERS
416 North State Street
Jackson, Mississippi 39201

## WATER WELL DRILLERS LOG

8-4-78 19 Quinn Water Well ~~Ser~~ Simpson
date well completed — firm name — county well located

LANDOWNER: Walter Rhodes

(mailing address)

WELL LOCATION:
sec. 23 T 2 N ~~S~~ R 3 E ~~W~~

miles (distance) (direction) of (nearest town)

WELL PURPOSE:
(home, irrigation, municipal, industrial)

WELL COMPLETION DATA:

(1) diameter (inches) 2"

(2) total depth (feet) 230

(3) static water level (feet) 78 below ~~above~~ top of ground.

(4) casing PVC (material), 210 (depth),
2 (size) if telescope see back.

(5) screen 20 (length), 210 (depth to top)
2 (size), 20 (material)

(6) pump 1 (HP) 4 (yield gpm)
(type power)

(7) electric log (yes or no)
MGS
(organization running log)

(8) how well bottom plugged BWV

DRILLERS REMARKS:

| description of formations encountered | from | to |
|---|---|---|
| Clay | 0 | 195 |
| Sand | 195 | 230 |

RECEIVED
DEC 13 1978
MISS. BD. OF WATER COMM.

If well telescopes please sketch and show depths.

GROUND LEVEL

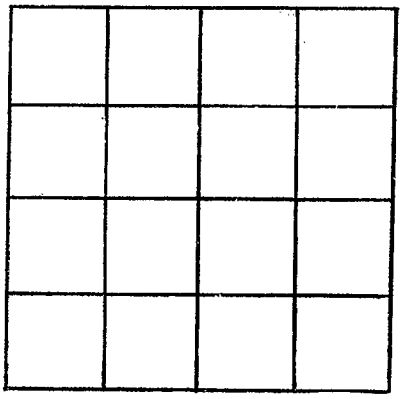

SECTION _____

Please indicate well location X.

ADDITIONAL INFORMATION

If more than one screen, show locations of each on sketch.