MISSISSIPPI DEPARTMENT OF ENVIRONMENTAL QUALITY

Office of Land and Water Resources

P. O. Box 10631
Jackson, MS 39289-0631

WATER WELL DRILLERS LOG

COUNTY WELL LOCATED	Simpson Simpson Co
WELL NUMBER	407009
CODED	
	G-2008
DATE WELL COMPLETED	2-8-01
PERMIT NUMBER	510
NAME OF DRILLING FIRM	Easley Waterwell
	B'haven MS 39601

NAME & MAILING ADDRESS OF LANDOWNER: Laveria Jamison

4130 Gatewilp Rd

WELL LOCATION: SEC 23 TOWNSHIP 1 (N) S RANGE 1 (E) W

DISTANCE ____ Miles DIRECTION ____ of NEAREST TOWN ____

OTHER LANDMARK

WELL PURPOSE: (Home), Irrigation, Municipal, Industrial, Fish Pond, etc.

PUMP DATA

PUMP TYPE (Circle One): (Submersible), Turbine, Jet, Flowing Well, Other (Describe) ____

POWER TYPE (Circle One): (Electric), Tractor, Diesel, Gasoline, Butane, Other (Describe) ____ H/P ____

Pump Capacity (GPM)	No. of Stages	Setting Depth
		FT.

PUMP TEST

Well yielded ____ GPM with a drawdown of ____ ft. after ____ hours of pumping

WELL DATA

Well Depth	Casing Diameter (In.)	Casing Length (Ft.)
320	4"	290
Type of Casing	**Hole Depth**	**Depth to Static Water Level**
PVC	360	

TYPE OF COMPLETION: (Circle One or More): Gravel Packed, Underreamed, Telescoped, (Natural Development), Open Hole, Other (Describe) ____

WELL GROUTED TO A DEPTH OF 10 FEET
Type Grout (circle one): (Cement), Bentonite, or Mix

LOG DATA

TYPE OF LOG RUN (Circle One): No Log Run, Electric, Gamma Ray, Density, Sonic, Neutron, Other (Describe) ____

Name of Organization Running Log

GEOLOGIC DATA (Office Use Only)

Surface Elev.	Geologic Unit	Unit Thickness	Depth to Top
Subs. SWL	Date	Analysis	Aquifer Test

Driller's Remarks

SCREEN DATA

Diameter - Inches	Length - Feet	Slot Size - Inches
4"	20'	0.8
Screen Type	**Depth to Bottom - Feet**	
PVC		

Top of Lap Pipe or Reduction in Casing

FEET — IF TELESCOPED OR MORE THAN ONE SCREEN: USE BACK PAGE

DESCRIPTION OF FORMATIONS ENCOUNTERED	FROM	TO
Clay	0	10
Sand	10	40
Clay	40	290
Sand	290	320
Clay	320	360

FORMATIONS (Continued)	FROM	TO

REC'D JUN 13 2001

IF MORE SPACE IS NEEDED, USE BACK

If well telescopes please
sketch and show depths.

GROUND LEVEL

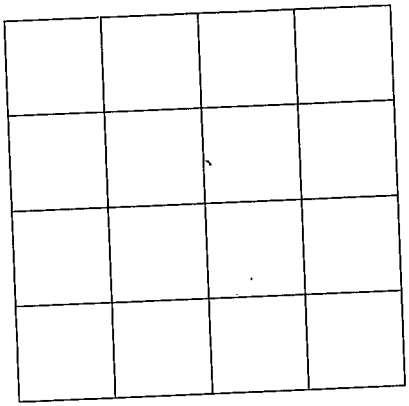

SECTION _____

Please indicate well location X.

ADDITIONAL INFORMATION

If more than one screen,
show location of each on sketch.