MISSISSIPPI DEPARTMENT OF ENVIRONMENTAL QUALITY
Office of Land and Water Resources

P. O. Box 10631
Jackson, MS 39289-0631
WATER WELL DRILLERS LOG

COUNTY WELL LOCATED: Simpson	
WELL NUMBER: N-3053	CODED:
DATE WELL COMPLETED: 9-12-2000	
PERMIT NUMBER: 10-586	
NAME OF DRILLING FIRM: James Wells Water Well Ser.	

NAME & MAILING ADDRESS OF LANDOWNER
Micheal Trinh
169 Lem Sullivan Rd
Pinola MS. 39149

WELL LOCATION	SEC	TOWNSHIP	RANGE
	21	10 (N) S	20 (E) W

DISTANCE	DIRECTION	NEAREST TOWN
6 Miles	South of	Pinola

OTHER LANDMARK

WELL PURPOSE: Irrigation, Municipal, Industrial, Fish Pond, etc.

PUMP DATA

PUMP TYPE (Circle One): Submersible, Turbine, Jet, Flowing Well, Other (Describe) _____

POWER TYPE (Circle One): Electric, Tractor, Diesel, Gasoline, Butane, Other (Describe) _____ H/P 2

Pump Capacity (GPM)	No of Stages	Setting Depth
		FT.

PUMP TEST

Well yielded 30 GPM with a drawdown of _____ ft. after _____ hours of pumping

WELL DATA

Well Depth	Casing Diameter (In.)	Casing Length (Ft.)
150	4	130

Type of Casing	Hole Depth	Depth to Static Water Level
PVC	150	105

TYPE OF COMPLETION: (Circle One or More): Gravel Packed, Underreamed, Telescoped, Natural Development, Open Hole, Other (Describe) _____

WELL GROUTED TO A DEPTH OF 15 FEET
Type Grout (circle one): Cement, Bentonite, or Mix

LOG DATA

TYPE OF LOG RUN (Circle One): No Log Run, Electric, Gamma Ray, Density, Sonic, Neutron, Other (Describe) _____

Name of Organization Running Log

GEOLOGIC DATA (Office Use Only)

Surface Elev	Geologic Unit	Unit Thickness	Depth to Top
Subs. SWL	Date	Analysis	Aquifer Test

Driller's Remarks

SCREEN DATA

Diameter - Inches	Length - Feet	Slot Size - Inches
4	20	008

Screen Type	Depth to Bottom - Feet
PVC	130-150

Top of Lap Pipe or Reduction in Casing FEET

IF TELESCOPED OR MORE THAN ONE SCREEN: USE BACK PAGE

DESCRIPTION OF FORMATIONS ENCOUNTERED	FROM	TO	FORMATIONS (Continued)	FROM	TO
Red Clay	0	15			
Red Sand	15	60			
Red Gravel	60	150			
			IF MORE SPACE IS NEEDED, USE BACK		

RECD JUL 25 2001

If well telescopes please sketch and show depths.

GROUND LEVEL

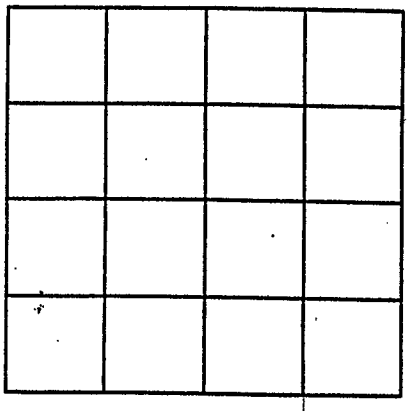

SECTION _____

Please indicate well location X.

ADDITIONAL INFORMATION

If more than one screen,