

MISSISSIPPI DEPARTMENT OF NATURAL RESOURCES

Bureau of Land and Water Resources

Southport Mall

P.O. Box 10631

Jackson, Mississippi 39209

WATER WELL DRILLERS LOG

Griner Drilling Service, Inc.

Simpson

CODED

Simpson
 44
 5-13-86

5-13-86

date well completed

firm name

county well located

LANDOWNER:

description of formations encountered

from

to

Exeter Drilling
 144 Elk Place
 Suite 1502

clay

0 10

New Orleans, La. 70112

sand, gravel

10 290

WELL LOCATION: 2300 S & 1200 W

sec. 35 T 10 N R 19 E of rock, clay

290 294

No. 1 Oak Grove Field
 35-8 (distance) miles (direction) of (nearest town)

WELL PURPOSE: oilfield supply well
 (home, irrigation, municipal, industrial)

WELL COMPLETION DATA:

(1) diameter (inches) 3"
 (2) total depth (feet) 294'
 (3) static water level (feet) 75' below top of ground.

(4) casing steel 252' (material) (depth)
 3" (size) if telescope see back.

(5) screen 42' 210' (length) (depth to top)
 3" perforated (size) (material)


(6) pump - 70 (HP) (yield gpm)
 AC (type power)

(7) electric log (yes or no)
 (organization running log)

(8) how well bottom plugged orange peel

DRILLERS REMARKS:


CODED

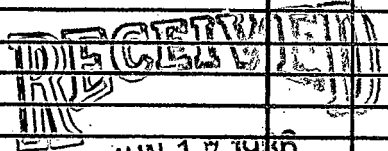

Department of Natural Resources
 Bureau of Land and Water Resources

If well telescopes please sketch and show depths.

GROUND LEVEL

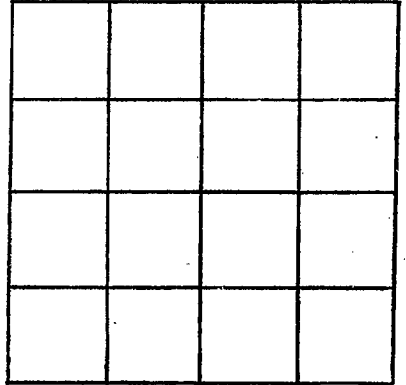

SECTION _____

Please indicate well location X.

ADDITIONAL INFORMATION

If more than one screen, show locations of each on sketch.