

A 116  
7-18-64

WATER WELL DRILLERS LOG

Date: July 18, 1964, Driller: W. G. Butler County Smith  
(Name)


(1) Owner of Land: Wm. Leon Hollingsworth  
(Name)  
Morton, R+4, Miss  
(Address)  
(2) Location: 1/4, 1/4, Sec 15 T4R6E4  
1 1/2 miles East of Polkville  
(distance) (direction) (Nearest Town)  
(3) Topography: Level  
(Hilly) (Flat) (Level)  
(4) Purpose of Well: Domestic  
(Domestic Irrigation  
Municipal, Industrial, Other)

Description & Color of Materials Sand, Clay, Red Clay, Shell, etc.	Thick- ness Feet	Depth Feet
clay	1-	5
sand	5-	10
Blue Chalk	10-	25
sand + lignite	25-	30
chalk	30-	35
sand	35-	40
Chalk + lignite	40-	45
sand + chalk	45-	60
chalk	60-	70
lignite	70-	77
sand	77-	90
chalk	90-	95

Information upon completion of well:

(1) Diameter 2 inches.  
(2) Total Depth 95 feet.  
(3) Water Level 70 feet below top of ground.  
(4) Cased to 88', Size 2"  
(5) Screen: Size 2", Length 5'  
(6) Were any formations sealed against pollution?  
yes, no.

If YES depth of formation \_\_\_\_\_  
Why \_\_\_\_\_  
Drillers Remarks: \_\_\_\_\_

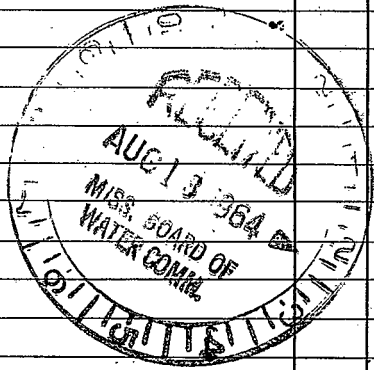

(Use Back Side)

Well No.





