SMITH

B 2001

12-18-78

MISSISSIPPI
BOARD OF WATER COMMISSIONERS
416 North State Street
Jackson, Mississippi 39201

WATER WELL DRILLERS LOG

12 18 1978 Roy Verstuyft Water Wells Smith
date well completed — firm name — county well located

LANDOWNER: Gonie Bishop
Rt 1
Paulaski
(mailing address)

WELL LOCATION:
sec 24 T 4 N/S R 7 E/W
1½ miles W of Lemon
(distance) (direction) (nearest town)

WELL PURPOSE: home
(home, irrigation, municipal, industrial)

WELL COMPLETION DATA:

(1) diameter (inches) 4
(2) total depth (feet) 138
(3) static water level (feet) 70 below/above top of ground.
(4) casing PVC (material), 118 (depth),
_____ (size) if telescope see back.
(5) screen 20 (length), 118 (depth to top)
4 (size), PVC (material)
(6) pump 1 (HP) 25 (yield gpm)
Rea (type power)
(7) electric log no (yes or no)
_____ (organization running log)
(8) how well bottom plugged wash value

DRILLERS REMARKS:

description of formations encountered	from	to
red clay	0	20
Blue clay	20	110
fine sand	110	138

RECEIVED
JAN 12 1978
MISS. BD. OF WATER COMM.

If well telescopes please sketch and show depths.

GROUND LEVEL

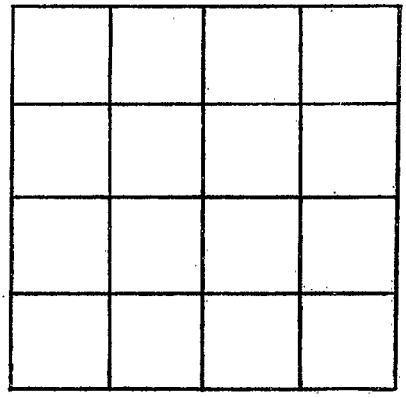

SECTION _____

Please indicate well location X.

ADDITIONAL INFORMATION

If more than one screen, show locations of each on sketch.