SMITH
5 C3
12-12-61

MISSISSIPPI BOARD OF WATER COMMISSIONERS

Sold

WATER WELL DRILLERS LOG

Date: 12/12, 1961, Driller: James McGee (Name) County Smith

(1) Owner of Land: R. R. Hawkins (Name)

Rt. 2, Forest, Miss. (Address)

(2) Location: ¼, ¼, Sec. R

This well is located about 14 miles South of Forest on Hwy. 35. Just South of Lorena Baptist Church on left of Hwy.

miles (distance) (direction) of (Nearest Town)

Sec 17 4N 8E

(3) Topography: x (Hilly) (Flat) (Level)

(4) Purpose of Well: Domestic. (Domestic Irrigation Municipal, Industrial, Other)

Information upon completion of well:

(1) Diameter 2" inches.

(2) Total Depth 632 feet.

(3) Water Level 192 feet below top of ground.

(4) Cased to 617', Size 2",

(5) Screen: Size 2" XXX, Length 15'.

(6) Were any formations sealed against pollution?

yes, x no.

If YES depth of formation,

Why

Drillers Remarks: Good well.

air comp.

Hard.

CNW Sec 17 T4N R8E

Retain this copy for your office files.

Description & Color of Materials Sand, Clay, Red Clay, Shell, etc.	Thickness Feet	Depth Feet
Red clay.	0-	12
Clay.	12-	52
Clay & sand.	52-	82
Sand.	82-	120
Sand & stks. clay.	120-	140
Clay.	140-	185
Rock.	185-	187
Clay & stks. rock.	187-	202
Shale.	202-	402
Shale & stks. rock.	402-	460
Shale.	460-	500
Shale & stks. sand.	500-	520
Fine sand & mucky clay.	520-	530
Mucky clay.	530-	540
Fine sand.	540-	550
Mucky clay.	550-	557
Fine sand & clay.	557-	580
Clay.	580-	600
Clay & stks. sand.	600-	612
Sand. (Screen setting)	612-	632

CL 3 C

SP CL 3 C

RECEIVED JAN 5 - 1961 MISS. BOARD OF WATER COMM.

(Use Back Side)

Well No.

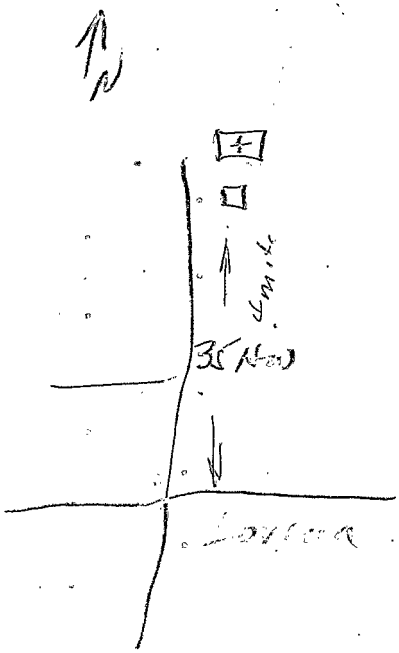
N
35 (Nov)