

SMITH

MISSISSIPPI BOARD OF WATER COMMISSIONERS

E 29

4-21-61

WATER WELL DRILLERS LOG

E 304

Date: April 21, 1961, Driller: W.G. Butler County Smiths

(Name)

(1) Owner of Land: W.C. Ouealy (Name)

Palbuilla Miss. (Address)

(2) Location: NW 1/4, NE 1/4, Sec. 17 T3 R6

10 miles North E. of Puckett (distance) (direction) (Nearest Town)

(3) Topography: (Hilly) (Flat) (Level)

(4) Purpose of Well: Domestic (Domestic Irrigation Municipal, Industrial, Other)

Description & Color of Materials Sand, Clay, Red Clay, Shell, etc.	Thick- ness Feet	Depth Feet
Clay	1-10	
Chalk	10-35	
Rock	35-70	
Chalk	70-75	
Sand	75-80	
Gumbo	80-90	
Gray Gumbo	90-100	
Gray Chalk Gumbo	100-110	
" " "	110-120	
Gumbo + lignite	120-130	
Gumbo	130-140	
Shell + Gumbo	140-150	
" " "	150-160	
Sand	160-190	

Information upon completion of well:

(1) Diameter 2 inches.

(2) Total Depth 190 feet.

(3) Water Level 18 feet below top of ground.

(4) Cased to 105'-2", Size 73' 1/4"

(5) Screen: Size 1/4", Length 12'

(6) Were any formations sealed against pollution?


yes, no.

If YES depth of formation

Why

Drillers Remarks:

E 2

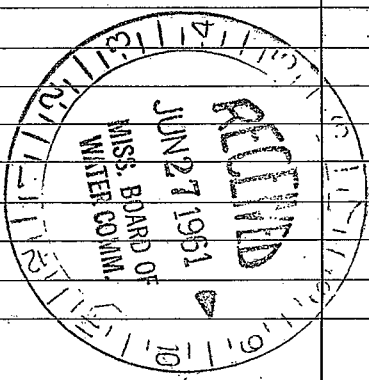

(Use Back Side)

Well No.








