Smith
N 2000
11/30/76

C. P. CLARK
WATER WELL DRILLING
ROUTE 2
LAUREL, MISS. 39440

MISSISSIPPI
BOARD OF WATER COMMISSIONERS
416 North State Street
Jackson, Mississippi 39201

13¢

WATER WELL DRILLERS LOG

11/30 1976 — date well completed
C.P. Clark — firm name
Smith — county well located

LANDOWNER: C.P. McCallum
Rt 2
Taylorsville Miss
(mailing address)

WELL LOCATION:
sec. 32 T 1 (N) S R 8 (E) W
5 miles (distance) N.W (direction) of Taylorsville (nearest town)

WELL PURPOSE: Home
(home, irrigation, municipal, industrial)

WELL COMPLETION DATA:

(1) diameter (inches) 2
(2) total depth (feet) 392
(3) static water level (feet) 102 below above top of ground.
(4) casing Galvanized 382
(material), (depth)
_____ (size) if telescope see back.
(5) screen 10, 382
(length), (depth to top)
1 1/4, Solid S.S.
(size), (material)
(6) pump 2 (HP) 5 (yield gpm)
220V electric
(type power)
(7) electric log No
(yes or no)
_____
(organization running log)
(8) how well bottom plugged Bwo

DRILLERS REMARKS: Set 147 ft 1 1/4 in with 84 ft

description of formations encountered	from	to
Sandy Clay	0	15
Clay	15	65
Clay & Sand Streaks	65	75
Sand	75	121
Clay	121	166½
Sand	166½	167
Blue Clay	167	260
Green Clay & Blue Sand S.	260	370
Sand & Clay	370	380
Sand	380	392
Clay	392	420

RECEIVED
MAR 3 1977
MISS. BD. OF WATER COMM.

If well telescopes please sketch and show depths.

GROUND LEVEL

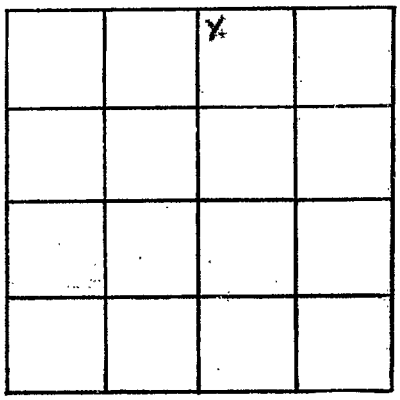

SECTION

Please indicate well location X.

ADDITIONAL INFORMATION

If more than one screen, show locations of each on sketch.