MISSISSIPPI DEPARTMENT OF ENVIRONMENTAL QUALITY
Bureau of Land and Water Resources

P. O. Box 10631
Jackson, MS 39289-0631
WATER WELL DRILLERS LOG

COUNTY WELL LOCATED: SMiTh	
WELL NUMBER: 2	CODED:
N 2009	PERMIT NUMBER:
DATE WELL COMPLETED: 6-13-92	NAME OF DRILLING FIRM: PARKer WELL SERVICE

NAME & MAILING ADDRESS OF LANDOWNER: RiCHARd MEADOWS MiZE MS.

WELL LOCATION: SEC 18 TOWNSHIP 1 (N) S RANGE 8 E (W)

DISTANCE 5 Miles DIRECTION SOUTH of NEAREST TOWN RALEIGH

OTHER LANDMARK:

WELL PURPOSE: Home, Irrigation, Municipal, Industrial, Fish Pond, etc. CHICKEN HOUSES

PUMP DATA

PUMP TYPE (Circle One): (Submersible) Turbine, Jet, Flowing Well, Other (Describe)

POWER TYPE (Circle One): (Electric) Tractor, Diesel, Gasoline, Butane, Other (Describe) H/P 1

Pump Capacity (GPM)	No. of Stages	Setting Depth
10	6	100 FT.

PUMP TEST

Well yielded 20 GPM with a drawdown of 80 ft. after 24 hours of pumping

WELL DATA

Well Depth	Casing Diameter (In.)	Casing Length (Ft.)
100	4"	80'

Type of Casing	Hole Depth	Depth to Static Water Level
PVC	138'	80'

TYPE OF COMPLETION: (Circle One or More): Gravel Packed, Underreamed, Telescoped, (Natural Development), Open Hole, Other (Describe)

Top of Lap Pipe or Reduction in Casing FEET

IF TELESCOPED OR MORE THAN ONE SCREEN: USE BACK PAGE

LOG DATA

TYPE OF LOG RUN (Circle One): No Log Run, Electric, (Gamma Ray) Density, Sonic, Neutron, Other (Describe)

Name of Organization Running Log: STATE

GEOLOGIC DATA (Office Use Only)

Surface Elev.	Geologic Unit	Unit Thickness	Depth to Top
Subs. SWL	Date	Analysis	Aquifer Test

Driller's Remarks: SET 2 SCREEN A CROSS BOTH SANDS MADE good WATER

SCREEN DATA

Diameter - Inches	Length - Feet	Slot Size - Inches
4"	20'	010

Screen Type	Depth to Bottom - Feet
PVC	100'

DESCRIPTION OF FORMATIONS ENCOUNTERED	FROM	TO
Red SAND	0	40
SAND	40	80
ROCK	80	81
WATER SAND	81	90
CHALK	90	91
SAND	91	100

FORMATIONS (Continued)	FROM	TO
Good Drinking WATER		

RECEIVED JUN 19 1992 Dept. of Environmental Quality Bureau of Land & Water Resources

IF MORE SPACE IS NEEDED, USE BACK

If well telescopes please
sketch and show depths.

GROUND LEVEL

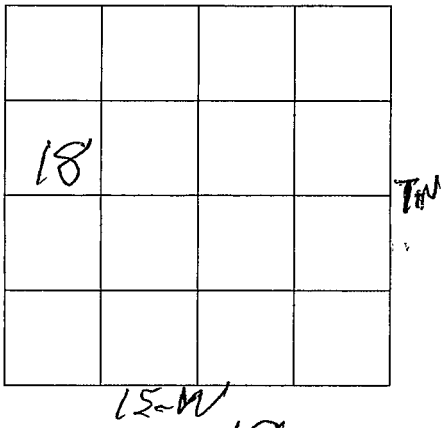

SECTION 18

Please indicate well location X.

ADDITIONAL INFORMATION

If more than one screen,
show location of each on sketch.