MISSISSIPPI DEPARTMENT OF ENVIRONMENTAL QUALITY
Bureau of Land and Water Resources

P. O. Box 10631
Jackson, MS 39289-0631

WATER WELL DRILLERS LOG

27ID

COUNTY WELL LOCATED: Smith	
WELL NUMBER: P 28	CODED: ✓
DATE WELL COMPLETED: 6-30-92	PERMIT NUMBER:
	NAME OF DRILLING FIRM: Parker Well Service

NAME & MAILING ADDRESS OF LANDOWNER
J.C. Bishop
Mize Miss.

WELL LOCATION: SEC H TOWNSHIP 10 (N) S RANGE 16 E (W)

DISTANCE 4 Miles DIRECTION West of NEAREST TOWN Mize

OTHER LANDMARK: Calvary Church Rd.

WELL PURPOSE: Home, Irrigation, Municipal, Industrial, Fish Pond, etc.
Chicken House

PUMP DATA

PUMP TYPE (Circle One): (Submersible) Turbine, Jet, Flowing Well, Other (Describe)

POWER TYPE (Circle One): (Electric) Tractor, Diesel, Gasoline, Butane, Other (Describe) H/P 1

Pump Capacity (GPM)	No. of Stages	Setting Depth
20	9	115 FT.

PUMP TEST

Well yielded 30 GPM with a drawdown of To 95 ft. ft. after 12 hours of pumping

WELL DATA

Well Depth	Casing Diameter (In.)	Casing Length (Ft.)
115	4"	95'

Type of Casing	Hole Depth	Depth to Static Water Level
PVC	115	84'

TYPE OF COMPLETION: (Circle One or More): Gravel Packed, Underreamed, Telescoped, (Natural Development) Open Hole, Other (Describe)

Top of Lap Pipe or Reduction in Casing FEET

IF TELESCOPED OR MORE THAN ONE SCREEN: USE BACK PAGE

SCREEN DATA

Diameter - Inches	Length - Feet	Slot Size - Inches
4"	20'	010

Screen Type	Depth to Bottom - Feet
PVC	115'

LOG DATA

TYPE OF LOG RUN (Circle One): No Log Run, Electric, Gamma Ray, Density, Sonic, Neutron, Other (Describe)

Name of Organization Running Log

GEOLOGIC DATA (Office Use Only)

Surface Elev.	Geologic Unit	Unit Thickness	Depth to Top
Subs. SWL	Date	Analysis	Aquifer Test

Driller's Remarks
Good Drinking Water

DESCRIPTION OF FORMATIONS ENCOUNTERED	FROM	TO
Red clay	0	20
Red Gravel	20	60
Sand	60	80
Clay	80	84
Sand	84	95
Clay	95	96
Sand	96	115

FORMATIONS (Continued)	FROM	TO

RECEIVED
JUL 01 1992
Dept. of Environmental Quality
Bureau of Land & Water Resources

IF MORE SPACE IS NEEDED, USE BACK

If well telescopes please
sketch and show depths.

GROUND LEVEL

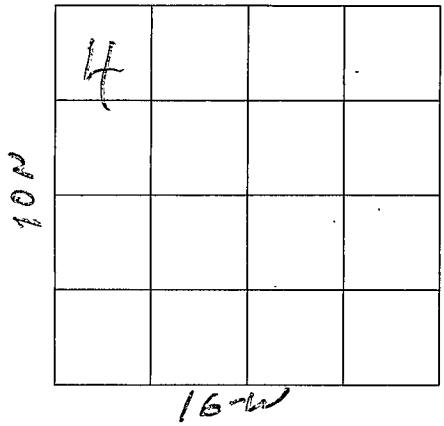

SECTION 4

Please indicate well location X.

ADDITIONAL INFORMATION

If more than one screen,
show location of each on sketch.