Smith.
R 33
3 CB

MISSISSIPPI
BOARD OF WATER COMMISSIONERS
416 North State Street
Jackson, Mississippi 39201

WATER WELL DRILLERS LOG

date well completed 19 — J.R. PARKER WELL DRILL (firm name) — SMITH (county well located)

LANDOWNER: BLAINE H. EATON
TAYLORSVILLE MISS
(mailing address)

WELL LOCATION:
sec. 10 T 10 (N) S R 14 E (W)
6 (distance) miles NORTH (direction) of TAYLORSVILLE (nearest town)

WELL PURPOSE: MUNICIPAL
(home, irrigation, municipal, industrial)

WELL COMPLETION DATA:
(1) diameter (inches) 4
(2) total depth (feet) 20
(3) static water level (feet) 10 below/above top of ground.
(4) casing P.V.C. (material), 14 ft. (depth), ____ (size) if telescope see back.
(5) screen 6 ft. (length), 20 ft. (depth to top), 1 1/4" (size), STAIN STEEL (material)
(6) pump 3/4 (HP) 5 (yield gpm) ELEC. (type power)
(7) electric log No (yes or no)
(organization running log)
(8) how well bottom plugged Point

DRILLERS REMARKS:

description of formations encountered	from	to
CLAY SANDRER	0	10
YELLOW CHALK	10	12
WATER SAND	12	20

JUN 11 1970
MISS. BD. OF WATER COMM.

If well telescopes please sketch and show depths.

GROUND LEVEL

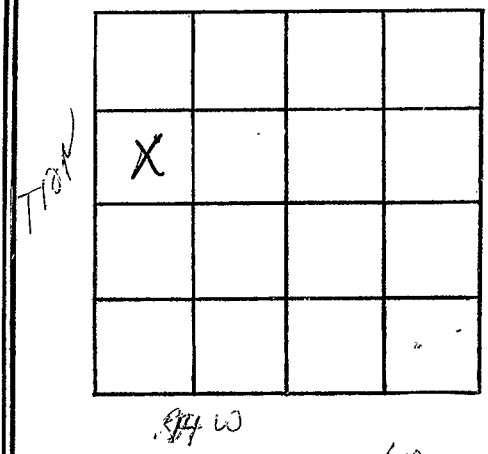

SECTION 10

Please indicate well location X.

ADDITIONAL INFORMATION

If more than one screen, show locations of each on sketch.