County: Smith
Permit #: 7402
Driller: Keith Parker
Date drilling completed: 5-24

STATE WELL REPORT
Part 1
Driller's Log

Mississippi Department of Environmental Quality
Office of Land and Water Resources
P.O. Box 2309
Jackson, MS 39225-2309
(601)961-5210
(601)360-0535 (fax)

For Office Use Only:
Well #: R108
Aquifer:
E-Log #:
294'

State Law requires that this report be prepared by the license holder responsible for the work and filed with the Department at the above address within 30 days of completion of drilling of the well or borehole.

Well Owner Information
(Landowner if borehole is not for a water well)

Owner Name: Baker Ford
Mailing Address: 8163 Hwy 37

Taylorsville MS 39168
City State Zip Code

Telephone No. (601) 433-1543

Well or Borehole Location

Latitude: 31.847239° Longitude: -89.441203°
31-50-50 -89-26-28
Method of Lat/Long (*check one*): Conventional Survey____, USGS quad____, Hand-held GPS____, Survey-grade GPS ~~____~~ ✓

NW ¼ SE ¼, Sec 27 T 10N R 14W

8 Miles N of Taylorsville
(Distance) (Direction) (Nearest Town)

Well / Borehole Data

Date drilling started: 5-20 Date drilling completed: 5-24 Hole depth: 405 Hole diameter: 6 1/2

Location of the source of any surface water used for drilling: ____

Method of dosing and volume of Chlorine used in drilling and development: 2 gals per 1000 gal

Logs run (*circle all applicable*): No log run Electric Gamma Ray Density Sonic Neutron Other: ____

Name of organization running log(s): ____

Purpose of borehole (*circle one*): (Water Well) Geotechnical/Geological Investigation Ground Source Heat Pump Seismic Survey Other (*describe*) ____

If drilling is not related to water well construction, skip the remainder of this block.

RECEIVED
JUL 24 2017
BY OLWR

Purpose of Well (*circle all applicable*): (Home) Industrial Public Supply Irrigation Fish Culture

Other (*describe*): ____

If a flowing well, method of flow regulation: Valve ____ Other (*describe*) ____

Static Water Level: 200 feet [above or below] land surface (*circle one*) Date measured: 5-24

Method of measurement (*circle one*): (Steel tape) Electric tape Air line Other (*describe*): ____

Well depth: 405 Well grouted to a depth of: 10 feet Type of grout (*circle one*): (Neat Cement) Bentonite Mix

Casing length: 385 feet Casing diameter: 4" inches Type of casing: PVC

Screen length: 20 feet Screen diameter: 4" inches Type of screen: PVC

Screen slot size: 8 inches Setting depth: From 385 feet to 405 feet

Type of completion (*circle all applicable*): Gravel packed Underreamed Open hole (Natural Development)

Other (*describe*): ____

Top of lap pipe or reduction in casing: 2 feet

If telescoped or more than one screen, describe on next page

Form: OLWR-SWR-1A (4/13)

County: _____

Permit #: _____

For Office Use Only:

Well #: R108

The sketch below only required for water wells

If well telescopes, show depths on sketch.

Ground Level

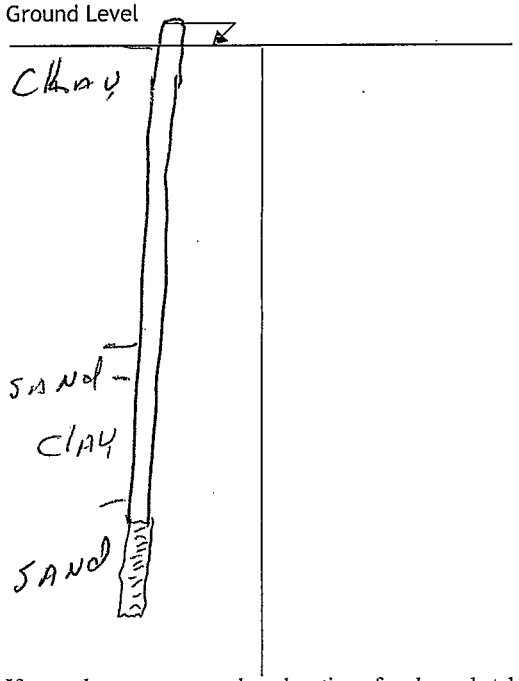

If more than one screen, show location of each on sketch

Description of formations encountered must be provided for all wells and boreholes, unless specifically exempted by regulations

Description of Formations Encountered	From (*depth*)	To (*depth*)
CLAY	Ground level	360'
SAND		5"
CLAY		80'
SAND		25'

Sketch the property layout and include the following:

1) the well location
2) any permanent structures on the property that may aid in locating the well
3) any roads, power lines, or other items that may aid in locating the property and the well
4) north arrow

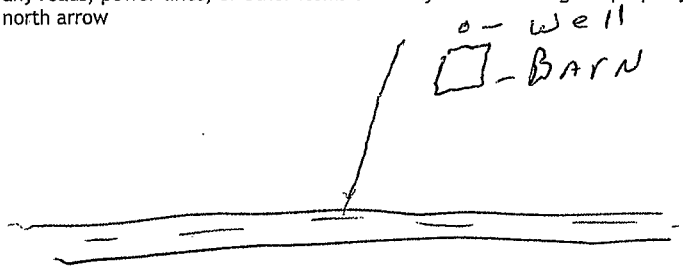

RECEIVED
JUL 24 2017
BY OLWR

Landowner Name: _____

I HEREBY CERTIFY that the well/borehole was drilled, constructed, and completed in accordance with all applicable requirements of the Mississippi Department of Environmental Quality and the Mississippi Department of Health regulations, if applicable, and state laws.

Keith Parker 7402 — Print Name of Responsible Licensee and License No.

5-24 — Date

Keith Parker — Signature of Licensee

Form: OLWR-SWR-1B (*4/13*)