STONE
A24
5-31-74

MISSISSIPPI
BOARD OF WATER COMMISSIONERS
416 North State Street
Jackson, Mississippi 39201

WATER WELL DRILLERS LOG

CODED

5-31 1974 Parnell Anderson Stone
date well completed | firm name | county well located

LANDOWNER: Bill Reeter

(mailing address)

WELL LOCATION:
sec. 11 T 2 S R 13 W

18 miles W of Wiggs
(distance) (direction) (nearest town)

WELL PURPOSE: HO ME
(home, irrigation, municipal, industrial)

WELL COMPLETION DATA:

(1) diameter (inches) 8"

(2) total depth (feet) 101'

(3) static water level (feet) 60' below ~~above~~ top of ground.

(4) casing Plastic 96'
(material) (depth)

_____ if telescope see back.
(size)

(5) screen 5', 96'
(length) (depth to top)
2", Plastic
(size) (material)

(6) pump 1 9
(HP) (yield gpm)
Elect
(type power)

(7) electric log no
(yes or no)

(organization running log)

(8) how well bottom plugged Plugged

DRILLERS REMARKS:

description of formations encountered	from	to
Top Soil	0	4
White Clay	4	62
Blue Clay	62	89
Coarse Sand	89	101

CODED

RECEIVED
JUN 6 1974
MISS. BD OF WATER COMM

If well telescopes please sketch and show depths.

GROUND LEVEL

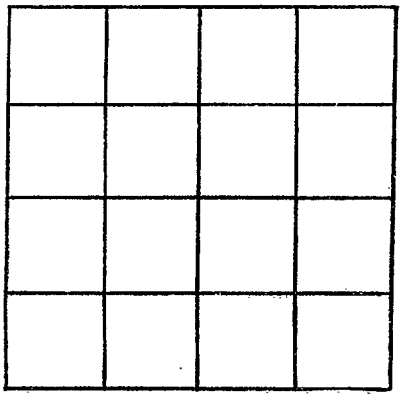

SECTION _____

Please indicate well location X.

ADDITIONAL INFORMATION

If more than one screen, show locations of each on sketch.