MISSISSIPPI DEPARTMENT OF ENVIRONMENTAL QUALITY
Office of Land and Water Resources
P. O. Box 10631
Jackson, MS 39289-0631
WATER WELL DRILLERS LOG

COUNTY WELL LOCATED	Stone
WELL NUMBER	B
CODED	2060
DATE WELL COMPLETED	7-13-98
PERMIT NUMBER	
NAME OF DRILLING FIRM	Moores Water Well Serv. 31R Moore Rd, Wiggins

NAME & MAILING ADDRESS OF LANDOWNER
Kurt Adams
P.O Box 224
Perkingston, MS, 39573

WELL LOCATION: SEC 28 TOWNSHIP 2 S RANGE 12 W

DISTANCE 3 Miles DIRECTION West of NEAREST TOWN Wiggins

OTHER LANDMARK
just past Batson Catfish Pond

WELL PURPOSE: Home, Irrigation, Municipal, Industrial, Fish Pond, etc.

PUMP DATA

PUMP TYPE (Circle One): Submersible, Turbine, Jet, Flowing Well, Other (Describe) _____

POWER TYPE (Circle One): Electric, Tractor, Diesel, Gasoline, Butane, Other (Describe) _____ H/P _____

Pump Capacity (GPM)	No. of Stages	Setting Depth
20	2	FT.

PUMP TEST
Well yielded _____ GPM with a drawdown of _____ ft. after _____ hours of pumping

WELL DATA

Well Depth	Casing Diameter (In.)	Casing Length (Ft.)
128'	2"	118'

Type of Casing	Hole Depth	Depth to Static Water Level
PVC	128'	Flowing "stream

TYPE OF COMPLETION: (Circle One or More): Gravel Packed, Underreamed, Telescoped, Natural Development, Open Hole, Other (Describe) _____

WELL GROUTED TO A DEPTH OF 10 FEET
Type Grout (circle one): Cement, Bentonite, or Mix

LOG DATA

TYPE OF LOG RUN (Circle One): No Log Run, Electric, Gamma Ray, Density, Sonic, Neutron, Other (Describe) _____

Name of Organization Running Log

GEOLOGIC DATA (Office Use Only)

Surface Elev.	Geologic Unit	Unit Thickness	Depth to Top
Subs. SWL	Date	Analysis	Aquifer Test

Driller's Remarks

Top of Lap Pipe or Reduction in Casing
FEET — IF TELESCOPED OR MORE THAN ONE SCREEN: USE BACK PAGE

SCREEN DATA

Diameter - Inches	Length - Feet	Slot Size - Inches
2"	10'	.08

Screen Type	Depth to Bottom - Feet
PVC sch40	128'

DESCRIPTION OF FORMATIONS ENCOUNTERED	FROM	TO	FORMATIONS (Continued)	FROM	TO
topsoil	1'	2'			
red sandy clay	2'	8'			
white soapstone	8'	10'	07-16-98A09:20 RCVD		
white sand	10'	22'			
Blue soapstone	22'	100'			
Coarse Blue sand & gravel	100'	128'			
			IF MORE SPACE IS NEEDED, USE BACK		

If well telescopes please
sketch and show depths.

GROUND LEVEL

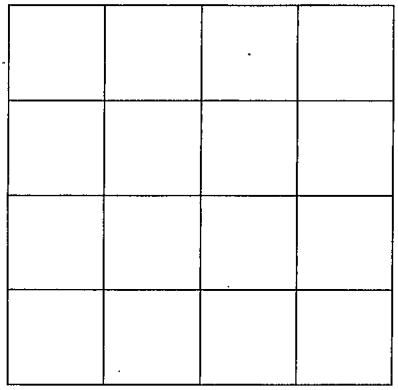

SECTION _____

Please indicate well location X.

ADDITIONAL INFORMATION

If more than one screen,
show location of each on sketch.