Stone
C 32
4-14-70

MISSISSIPPI
BOARD OF WATER COMMISSIONERS
416 North State Street
Jackson, Mississippi 39201

WATER WELL DRILLERS LOG

4-14 1970 — date well completed
L W Smith — firm name
Stone — county well located

LANDOWNER: James Scott
Wiggins (mailing address)

WELL LOCATION:
sec. 20 T 2 (S) R 11 (W) 164
one (distance) miles E (direction) of WIGGINS (nearest town)

WELL PURPOSE:
(home, irrigation, municipal, industrial)

WELL COMPLETION DATA:

(1) diameter (inches) 2
(2) total depth (feet) 55
(3) static water level (feet) 21 below above top of ground.
(4) casing Plastic (material), 50 (depth),
_____ (size) if telescope see back.
(5) screen 5 (length), 50 (depth to top)
_____ (size), _____ (material)
(6) pump 1 (HP) 15 (yield gpm)
Electric (type power)
(7) electric log _____ (yes or no)
_____ (organization running log)
(8) how well bottom plugged Cab

DRILLERS REMARKS:

description of formations encountered	from	to
Sand	0	55

MAY 11 1970
MISS. BD. OF WATER COMM.

If well telescopes please sketch and show depths.

GROUND LEVEL

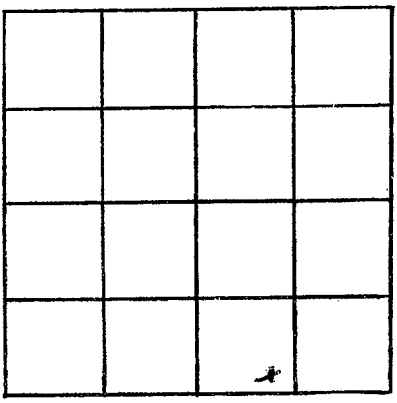

SECTION _____

Please indicate well location X.

ADDITIONAL INFORMATION

If more than one screen, show locations of each on sketch.