STONE
C55
8-8-73

MISSISSIPPI
BOARD OF WATER COMMISSIONERS
416 North State Street
Jackson, Mississippi 39201

WATER WELL DRILLERS LOG

8-8 19 73 Pearl Anderson Stone
date well completed — firm name — county well located

LANDOWNER: Mary Price
Rt 1 Box 215 Wiggins
(mailing address)

WELL LOCATION:
sec 17 T 2 S R 11 W
2 miles W of Wiggins
(distance) (direction) (nearest town)

WELL PURPOSE: HOME
(home, irrigation, municipal, industrial)

WELL COMPLETION DATA:
(1) diameter (inches) 2"
(2) total depth (feet) 85'
(3) static water level (feet) 5-0 below ~~above~~ top of ground.
(4) casing Plastic (material), 80' (depth),
_____ (size) if telescope see back.
(5) screen 15' (length), 80' (depth to top)
2" (size), Plastic (material)
(6) pump 1 (HP) 10 (yield gpm)
Electricity (type power)
(7) electric log no (yes or no)
_____ (organization running log)
(8) how well bottom plugged: Backwash Valve

DRILLERS REMARKS:

description of formations encountered	from	to
Top Soil	0	4
Red Clay	2	16
Pink Clay	16	18
Fine Sand	18	62
Course Sand	62	85

CODED

RECEIVED 5 1973 MISS. BD. OF WATER COMM.

If well telescopes please sketch and show depths.

GROUND LEVEL

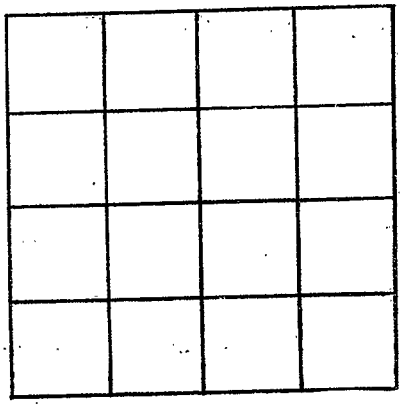

SECTION _____

Please indicate well location X.

ADDITIONAL INFORMATION

If more than one screen, show locations of each on sketch.