MISSISSIPPI DEPARTMENT OF ENVIRONMENTAL QUALITY
Office of Land and Water Resources

P. O. Box 10631
Jackson, MS 39289-0631
WATER WELL DRILLERS LOG

COUNTY WELL LOCATED	Stone
WELL NUMBER	C-2131
CODED	
DATE WELL COMPLETED	10-4-99
PERMIT NUMBER	
NAME OF DRILLING FIRM	Bones Water Well

NAME & MAILING ADDRESS OF LANDOWNER
JoAnn Pope
924 King Bee Rd
Perkingston, Ms 39573

WELL LOCATION: SEC 3 TOWNSHIP 2 N (S) RANGE 11 E (W)

DISTANCE 7 Miles DIRECTION SE of NEAREST TOWN Wiggins

OTHER LANDMARK

WELL PURPOSE: Home, Irrigation, Municipal, Industrial, Fish Pond, etc.

PUMP DATA

PUMP TYPE (Circle One): Submersible, Turbine, Jet, Flowing Well, Other (Describe) hand Pump

POWER TYPE (Circle One): Electric, Tractor, Diesel, Gasoline, Butane, Other (Describe) Hand pump H/P

Pump Capacity (GPM)	No. of Stages	Setting Depth
		FT.

PUMP TEST

Well yielded _____ GPM with

a drawdown of _____ ft.

after _____ hours of pumping

WELL DATA

Well Depth	Casing Diameter (In.)	Casing Length (Ft.)
80	2"	70
Type of Casing	**Hole Depth**	**Depth to Static Water Level**
Sch 40	80	40

TYPE OF COMPLETION: (Circle One or More): Gravel Packed, Underreamed, Telescoped, Natural Development, Open Hole, Other (Describe) _____

WELL GROUTED TO A DEPTH OF 10 FEET
Type Grout (circle one): Cement, Bentonite, or Mix

LOG DATA

TYPE OF LOG RUN (Circle One): No Log Run, Electric, Gamma Ray, Density, Sonic, Neutron, Other (Describe) _____

Name of Organization Running Log

GEOLOGIC DATA (Office Use Only)

Surface Elev.	Geologic Unit	Unit Thickness	Depth to Top
Subs. SWL	Date	Analysis	Aquifer Test

Driller's Remarks

SCREEN DATA

Diameter - Inches	Length - Feet	Slot Size - Inches
2	10	#8
Screen Type		**Depth to Bottom - Feet**
Sch 40		

Top of Lap Pipe or Reduction in Casing
FEET

IF TELESCOPED OR MORE THAN ONE SCREEN: USE BACK PAGE

DESCRIPTION OF FORMATIONS ENCOUNTERED	FROM	TO
Sand	0	80

FORMATIONS (continued)	FROM	TO

IF MORE SPACE IS NEEDED, USE BACK

RECEIVED
JUL 27 2000
Dept. of Environmental Quality
Office of Land & Water Resources

If well telescopes please
sketch and show depths.

GROUND LEVEL

 

If more than one screen,
show location of each on sketch.

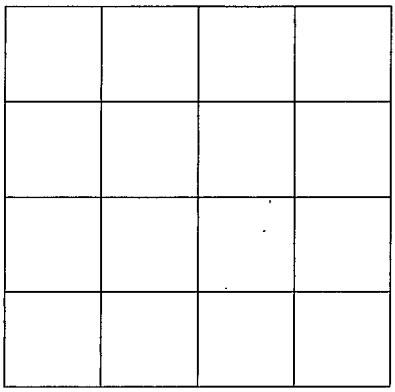

SECTION _____

Please indicate well location X.

ADDITIONAL INFORMATION