STONE
D26
11-7-74

MISSISSIPPI
BOARD OF WATER COMMISSIONERS
416 North State Street
Jackson, Mississippi 39201

WATER WELL DRILLERS LOG

CODED

11-7 1974 Parnell Anderson Stone
date well completed — firm name — county well located

LANDOWNER: David Schitt

(mailing address)

WELL LOCATION:

sec. 7 T 2 ~~N~~ (S) R 9 ~~E~~ (W)

16 miles E of Wiggins
(distance) (direction) (nearest town)

WELL PURPOSE: HOME
(home, irrigation, municipal, industrial)

WELL COMPLETION DATA:

(1) diameter (inches) 2"

(2) total depth (feet) 105'

(3) static water level (feet) 12' below ~~above~~ top of ground.

(4) casing Plastic, 100'
(material) (depth)

_____ if telescope see back.
(size)

(5) screen 5', 100'
(length) (depth to top)

2", Plastic
(size) (material)

(6) pump 1 12
(HP) (yield gpm)

Elect
(type power)

(7) electric log no
(yes or no)

(organization running log)

(8) how well bottom plugged Drilled

DRILLERS REMARKS:

description of formations encountered	from	to
Top Soil	0	5
Red Sand	5	18
White Clay	18	34
Blue Clay	34	87
Fine Sand	87	100
Coarse Sand	100	105

CODED

RECEIVED
DEC - 6 1974
MISS. BD. OF WATER COMM.

If well telescopes please sketch and show depths.

GROUND LEVEL

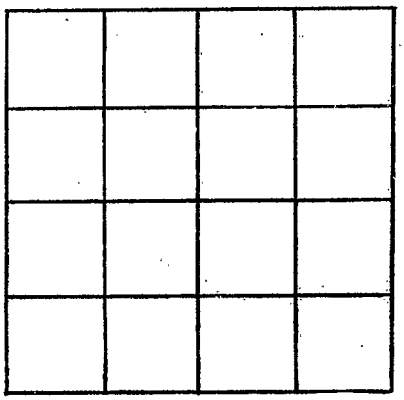

SECTION _____

Please indicate well location X.

ADDITIONAL INFORMATION

If more than one screen, show locations of each on sketch.