STONE
E8
2-17-71

MISSISSIPPI
BOARD OF WATER COMMISSIONERS
416 North State Street
Jackson, Mississippi 39201

CODED

WATER WELL DRILLERS LOG

2-17 1971 Parnell Anderson Stone
date well completed — firm name — county well located

LANDOWNER: Rayford Rogers
Rt
Perkinston, Miss
(mailing address)

WELL LOCATION:
sec. 33 T 3 N/S R 13 E/W
12 miles W of Perkinston
(distance) (direction) (nearest town)

WELL PURPOSE: Home
(home, irrigation, municipal, industrial)

WELL COMPLETION DATA:

(1) diameter (inches) 2"
(2) total depth (feet) 257
(3) static water level (feet) 90 below above top of ground.
(4) casing 2" (material), 252 (depth),
(size) if telescope see back.
(5) screen 5 (length), 252 (depth to top)
2" (size), Plastic (material)
(6) pump 1 (HP) 5 (yield gpm)
Electric (type power)
(7) electric log NO (yes or no)
(organization running log)
(8) how well bottom plugged Backwash Vale

DRILLERS REMARKS:

description of formations encountered	from	to
Top Soil	0	3
Red Clay	3	28
Fine Sand	28	33
Blue Clay	33	109
Fine Sand	109	124
Blue Clay	124	230
Fine Sand	230	242
Coarse Sand	242	257

CODED

JUN 3 1971
MISS. BD. OF
WATER COMMISS.

If well telescopes please sketch and show depths.

GROUND LEVEL

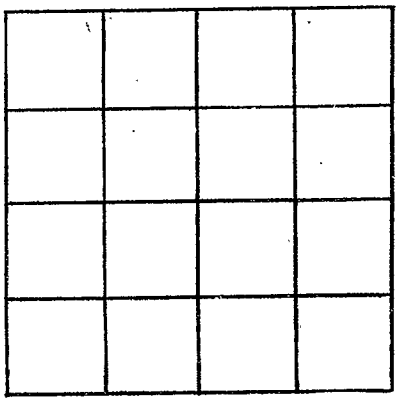

SECTION _____

Please indicate well location X.

ADDITIONAL INFORMATION

If more than one screen, show locations of each on sketch.