Stone
E
2030

MISSISSIPPI DEPARTMENT OF NATURAL RESOURCES

Bureau of Land and Water Resources
Southport Mall
P.O. Box 10631
Jackson, Mississippi 39209

WATER WELL DRILLERS LOG

1/15 1982 Lyman Well Stone
date well completed firm name county well located

LANDOWNER:
Chalmis Ladner
McHenry Ms.
(mailing address)

WELL LOCATION:
sec. 34 T. 3 N (S) R. 13 E (W)
5 miles W of McHenry Ms
(distance) (direction) (nearest town)

WELL PURPOSE: Home
(home, irrigation, municipal, industrial)

WELL COMPLETION DATA:

(1) diameter (inches) 2"
(2) total depth (feet) 50'
(3) static water level (feet) 40 below above top of ground.
(4) casing PVC (material), 40' (depth), 2" (size) If telescope see back.
(5) screen 10' (length), 50 (depth to top), 2" (size), PVC (material)
(6) pump 1 (HP) 12 (yield gpm) Elec. (type power)
(7) electric log NO (yes or no)
(organization running log)
(8) how well bottom plugged Sand Shark

DRILLERS REMARKS:

description of formations encountered	from	to
Red Sand & Gravel	0	50

DEPT. OF NATURAL RESOURCES
BUREAU OF LAND & WATER RESOURCES
APR 28 1982
RECEIVED

If well telescopes please sketch and show depths.

GROUND LEVEL

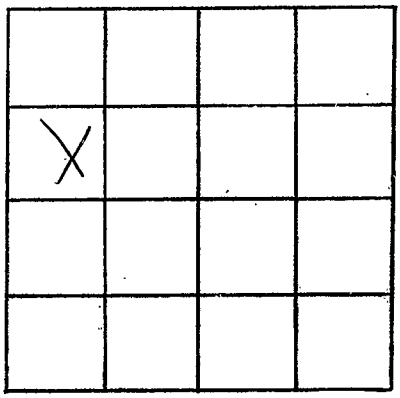

SECTION 5

Please indicate well location X.

ADDITIONAL INFORMATION

If more than one screen, show locations of each on sketch.