MISSISSIPPI DEPARTMENT OF ENVIRONMENTAL QUALITY

Office of Land and Water Resources

P. O. Box 10631
Jackson, MS 39289-0631

WATER WELL DRILLERS LOG

COUNTY WELL LOCATED	Stone
WELL NUMBER	E
CODED	
DATE WELL COMPLETED	2057 6/5/95
PERMIT NUMBER	
NAME OF DRILLING FIRM	Moore's Water Well
	31 R Moore Rd

NAME & MAILING ADDRESS OF LANDOWNER

Joyce Bower
P.O Box 10071
Gulfport, MS. 39505-0071

WELL LOCATION: SEC	TOWNSHIP	RANGE
3	3 S	13 W

DISTANCE	DIRECTION	NEAREST TOWN
10 Miles	W of	Perkinston

OTHER LANDMARK: just past Magnolia Com. Center

WELL PURPOSE: Home, Irrigation, Municipal, Industrial, Fish Pond, etc.: Home

PUMP DATA

PUMP TYPE (Circle One): Submersible, Turbine, Jet, Flowing Well, Other (Describe) _____

POWER TYPE (Circle One): Electric, Tractor, Diesel, Gasoline, Butane, Other (Describe) _____ H/P _____

Pump Capacity (GPM)	No. of Stages	Setting Depth
8	2	FT.

PUMP TEST

Well yielded _____ GPM with a drawdown of _____ ft. after _____ hours of pumping

WELL DATA

Well Depth	Casing Diameter (In.)	Casing Length (Ft.)
81'	2"	61'
Type of Casing	**Hole Depth**	**Depth to Static Water Level**
PVC	81'	35'

TYPE OF COMPLETION: (Circle One or More): Gravel Packed, Underreamed, Telescoped, Natural Development, Open Hole, Other (Describe) _____

WELL GROUTED TO A DEPTH OF 10 FEET
Type Grout (circle one): Cement, Bentonite, or Mix

LOG DATA

TYPE OF LOG RUN (Circle One): No Log Run, Electric, Gamma Ray, Density, Sonic, Neutron, Other (Describe) _____

Name of Organization Running Log

GEOLOGIC DATA (Office Use Only)

Surface Elev.	Geologic Unit	Unit Thickness	Depth to Top
Subs. SWL	Date	Analysis	Aquifer Test

Driller's Remarks

SCREEN DATA

Diameter - Inches	Length - Feet	Slot Size - Inches
2"	20'	.08
Screen Type		**Depth to Bottom - Feet**
PVC sch 40		81'

DESCRIPTION OF FORMATIONS ENCOUNTERED	FROM	TO
topsoil	0'	2'
red sandy Clay	2'	10'
sand & gravel	10'	40'
purple soapstone	40'	45'
coarse white sand & gravel	45'	81'

FORMATIONS (Continued)	FROM	TO

RECEIVED
JUL 10 1995
Dept. of Environmental Quality
Office of Land & Water Resources

IF MORE SPACE IS NEEDED, USE BACK

If well telescopes please
sketch and show depths.

GROUND LEVEL

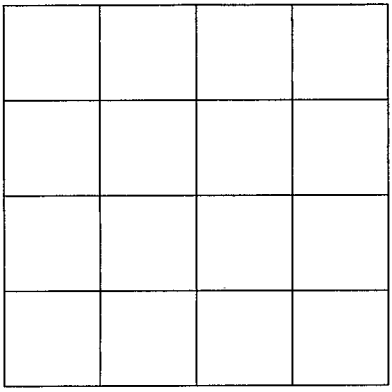

SECTION _____

Please indicate well location X.

ADDITIONAL INFORMATION

If more than one screen,
show location of each on sketch.