Need address and distance to nearest town.

STONE
F 2003
4-16-76

MISSISSIPPI
BOARD OF WATER COMMISSIONERS
416 North State Street
Jackson, Mississippi 39201

WATER WELL DRILLERS LOG

4-16 date well completed 1976 Farrell Anderson firm name Stone county well located

LANDOWNER: Author Parker
(mailing address)

WELL LOCATION:
sec 26 T 3 S R 12 W
(distance) miles (direction) of (nearest town)

WELL PURPOSE: HOME
(home, irrigation, municipal, industrial)

WELL COMPLETION DATA:
(1) diameter (inches) 2"
(2) total depth (feet) 86'
(3) static water level (feet) 38 below top of ground.
(4) casing Plastic, 81'
(material) (depth)
(size) If telescope see back.
(5) screen 5', 81'
(length) (depth to top)
2", Plastic
(size) (material)
(6) pump 1 10
(HP) (yield gpm)
Elect
(type power)
(7) electric log no
(yes or no)
(organization running log)
(8) how well bottom plugged Capped

DRILLERS REMARKS:

description of formations encountered	from	to
Top Soil	0	4
Red Clay	4	28
Fine Sand	28	66
Coarse Sand	66	86

RECEIVED
MAY -5 1976
BD. OF WATER COMM.

If well telescopes please sketch and show depths.

GROUND LEVEL

If more than one screen, show locations of each on sketch.

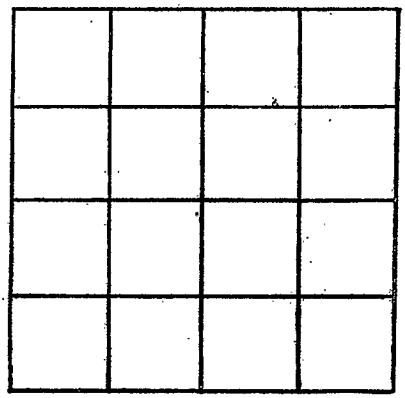

SECTION _____

Please indicate well location X.

ADDITIONAL INFORMATION