STONE
G 54
7-6-73

MISSISSIPPI
BOARD OF WATER COMMISSIONERS
416 North State Street
Jackson, Mississippi 39201

CODED

WATER WELL DRILLERS LOG

7-6 1973 Parnell Anderson Stone
date well completed — firm name — county well located

LANDOWNER: J. J. Roland

R.F.D. Perkinston
(mailing address)

WELL LOCATION:
sec 32 T 3 S R 11 W

5 miles N W of Perk
(distance) (direction) (nearest town)

WELL PURPOSE: HOME
(home, irrigation, municipal, industrial)

WELL COMPLETION DATA:

(1) diameter (inches) 2"

(2) total depth (feet) 57'

(3) static water level (feet) 30' below above top of ground.

(4) casing Plastic (material), 52' (depth),
(size) if telescope see back.

(5) screen 5' (length), 5 (depth to top)
2" (size), Plastic (material)

(6) pump 1 (HP) 7 (yield gpm)
Elect (type power)

(7) electric log no (yes or no)

(organization running log)

(8) how well bottom plugged Backwash valve

DRILLERS REMARKS:

description of formations encountered	from	to
Top Soil	0	3
Sandy Clay	3	18
Red Sand	18	35
Coarse Sand	35	57

CODED

RECEIVED NOV 5 1973

If well telescopes please sketch and show depths.

GROUND LEVEL

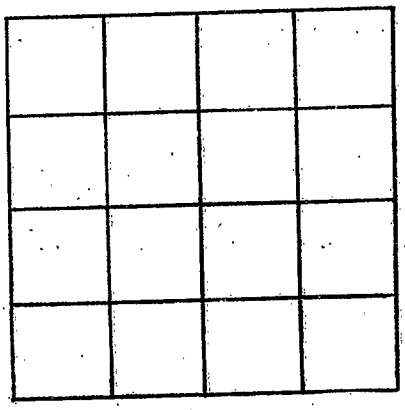

SECTION _____

Please indicate well location X.

ADDITIONAL INFORMATION

If more than one screen, show locations of each on sketch.