STONE
G57
11-1-73

MISSISSIPPI
BOARD OF WATER COMMISSIONERS
416 North State Street
Jackson, Mississippi 39201

WATER WELL DRILLERS LOG

11-1 date well completed 1973 Powell Anderson firm name Stone county well located

LANDOWNER: Thelma Mauffray
Rt 4 Perkinston
(mailing address)

WELL LOCATION:
sec. 2 T 3 (S) R 11 (W)
11 (distance) miles SE (direction) of Tilly (nearest town)

WELL PURPOSE: HOME
(home, irrigation, municipal, industrial)

WELL COMPLETION DATA:
(1) diameter (inches) 2"
(2) total depth (feet) 142'
(3) static water level (feet) 5'0" below above top of ground.
(4) casing Plastic (material), 137' (depth),
_____ (size) if telescope see back.
(5) screen 5' (length), 137' (depth to top)
2" (size), Plastic (material)
(6) pump 1 (HP) 10 (yield gpm)
Elect. (type power)
(7) electric log no (yes or no)
_____ (organization running log)
(8) how well bottom plugged Backwash Odom

DRILLERS REMARKS:

description of formations encountered	from	to
Top Soil	0	3
Fine Sand	3	80
Blue Clay	80	110
Fine Sand	110	130
Course Sand	130	142

CODED

DEC 10 1973

If well telescopes please sketch and show depths.

GROUND LEVEL

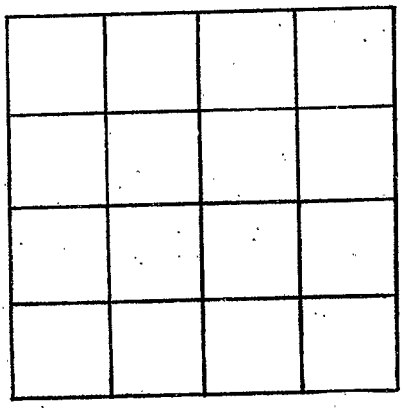

SECTION _____

Please indicate well location X.

ADDITIONAL INFORMATION

If more than one screen, show locations of each on sketch.