STONE
G59
11-20-73

MISSISSIPPI
BOARD OF WATER COMMISSIONERS
416 North State Street
Jackson, Mississippi 39201

WATER WELL DRILLERS LOG

11-20 19 Parnell Anderson Stone
date well completed — firm name — county well located

LANDOWNER: Gene Dedaw
Rt 1 Perkinston
(mailing address)

WELL LOCATION:
sec. 5 T 3 S R 11 W
3 miles NE of Perk
(distance) (direction) (nearest town)

WELL PURPOSE: HOME
(home, irrigation, municipal, industrial)

WELL COMPLETION DATA:

(1) diameter (inches) 2"

(2) total depth (feet) 85'

(3) static water level (feet) 65' below ~~above~~ top of ground.

(4) casing Plastic (material), 80' (depth),
_____ (size) if telescope see back.

(5) screen 5' (length), 80' (depth to top)
2" (size), Plastic (material)

(6) pump 1 (HP) 10 (yield gpm)
Elect (type power)

(7) electric log no (yes or no)
_____ (organization running log)

(8) how well bottom plugged Backwash valve

DRILLERS REMARKS:

description of formations encountered	from	to
Top Soil	0	3
Fine Sand	3	18
Pink Clay	18	55
Course Sand	55	85

CODED

CODED

DEC 10 1973
MISS. BD. OF WATER COMM.

If well telescopes please sketch and show depths.

GROUND LEVEL

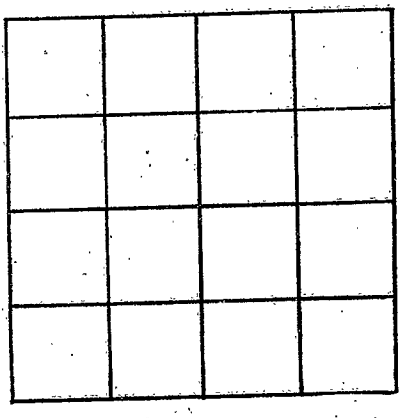

SECTION _____

Please indicate well location X.

ADDITIONAL INFORMATION

If more than one screen, show locations of each on sketch.