

MISSISSIPPI DEPARTMENT OF NATURAL RESOURCES

Bureau of Land and Water Resources

P.O. Box 10631

Jackson, Mississippi 39209

WATER WELL DRILLERS LOG

COUNTY WELL LOCATED <i>Stone</i>	
WELL NUMBER <i>CT</i>	CODED
DATE WELL COMPLETED <i>2/03</i> <i>12-28-90</i>	

PERMIT NUMBER
NAME OF DRILLING FIRM <i>Moore's Water Well Serv.</i>

NAME & MAILING ADDRESS OF LANDOWNER <i>Roger White</i> <i>511 Hillcrest Rd.</i> <i>Parkington</i>			
WELL LOCATION: SEC	TOWNSHIP	RANGE	
<i>6</i>	<i>3</i>	<i>N</i>	<i>11</i> <i>E</i>
DISTANCE _____ Miles		DIRECTION _____ of _____	
OTHER LANDMARK			
WELL PURPOSE: <input checked="" type="checkbox"/> Home Irrigation, <input type="checkbox"/> Municipal, <input type="checkbox"/> Industrial, <input type="checkbox"/> Fish Pond, etc.			

PUMP DATA		
PUMP TYPE (Circle One): <input checked="" type="radio"/> Submersible, <input type="radio"/> Turbine, <input type="radio"/> Jet, <input type="radio"/> Flowing Well, Other (Describe) _____		
POWER TYPE (Circle One): <input checked="" type="radio"/> Electric, <input type="radio"/> Tractor, <input type="radio"/> Diesel, <input type="radio"/> Gasoline, <input type="radio"/> Butane, Other (Describe) _____ H/P _____		
Pump Capacity (GPM) <i>8 gpm.</i>	No. of Stages	Setting Depth <i>90</i> FT.
PUMP TEST		
Well yielded _____ GPM with a drawdown of _____ ft. after _____ hours of pumping		

WELL DATA		
Well Depth <i>102'</i>	Casing Diameter (In.) <i>4"</i>	Casing Length (Ft.) <i>81'</i>
Type of Casing <i>Sch 40 PVC</i>	Hole Depth <i>130'</i>	Depth to Static Water Level <i>55'</i>
TYPE OF COMPLETION: (Circle One or More): <input checked="" type="radio"/> Gravel Packed, <input type="radio"/> Underreamed, <input type="radio"/> Telescoped, <input type="radio"/> Natural Development, <input type="radio"/> Open Hole, <input type="radio"/> Other (Describe) _____		
Top of Lap Pipe or Reduction in Casing		
FEET <input type="checkbox"/> IF TELESCOPED OR MORE THAN ONE SCREEN: USE BACK PAGE		


LOG DATA	
TYPE OF LOG RUN (Circle One): <input type="radio"/> No Log Run, <input type="radio"/> Electric, <input type="radio"/> Gamma Ray, <input type="radio"/> Density, <input type="radio"/> Sonic, <input type="radio"/> Neutron, <input type="radio"/> Other (Describe) _____	
Name of Organization Running Log	

SCREEN DATA		
Diameter - Inches <i>4"</i>	Length - Feet <i>20'</i>	Slot Size - Inches <i>.010</i>
Screen Type <i>PVC</i>	Depth to Bottom - Feet <i>101'</i>	

GEOLOGIC DATA (Office Use Only)			
Surface Elev.	Geologic Unit	Unit Thickness	Depth to Top
Subs. SWL	Date	Analysis	Aquifer Test

Driller's Remarks	

DESCRIPTION OF FORMATIONS ENCOUNTERED	FROM	TO	TO
<i>topsoil</i>	<i>1'</i>	<i>5'</i>	
<i>red clay</i>	<i>5'</i>	<i>12'</i>	
<i>red sand & clay</i>	<i>12'</i>	<i>19'</i>	
<i>fine gravel</i>	<i>4"</i>		
<i>pink soapstone</i>	<i>19'</i>	<i>20'</i>	
<i>pink coarse sand & gravel</i>	<i>20'</i>	<i>35'</i>	
<i>red & white soapstone</i>	<i>35'</i>	<i>76'</i>	
<i>sand</i>	<i>76'</i>	<i>102'</i>	

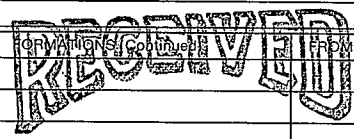


JAN 15 1991

Dept. of Environmental Quality
Bureau of Land & Water Resources

IF MORE SPACE IS NEEDED, USE BACK

If well telescopes please
sketch and show depths.

GROUND LEVEL

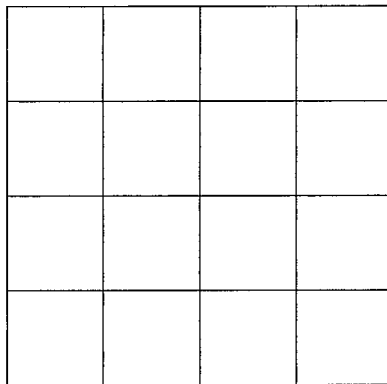

SECTION _____

Please indicate well location X.

ADDITIONAL INFORMATION

If more than one screen,
show location of each on sketch.
