MISSISSIPPI DEPARTMENT OF ENVIRONMENTAL QUALITY
Office of Land and Water Resources
P. O. Box 10631
Jackson, MS 39289-0631

WATER WELL DRILLERS LOG

COUNTY WELL LOCATED	Stone
WELL NUMBER	G 2431
CODED	
PERMIT NUMBER	
NAME OF DRILLING FIRM	Moores Water Well Service
31 R Moore Rd, Wiggins, MS	
DATE WELL COMPLETED	3/24/98

NAME & MAILING ADDRESS OF LANDOWNER
Charles Goodman
King Bee Rd.
Big Level, MS

WELL LOCATION: SEC 2 TOWNSHIP 3 S RANGE 11 W

DISTANCE 5 Miles DIRECTION East of NEAREST TOWN Wiggins

OTHER LANDMARK
Big Level grocery

WELL PURPOSE (Home) Irrigation, Municipal, Industrial, Fish Pond, etc.

PUMP DATA

PUMP TYPE (Circle One): Submersible, Turbine, Jet Flowing Well, Other (Describe) _____

POWER TYPE (Circle One): Electric, Tractor, Diesel, Gasoline, Butane, Other (Describe) _____ H/P _____

Pump Capacity (GPM)	No. of Stages	Setting Depth
		FT.

PUMP TEST
Well yielded _____ GPM with a drawdown of _____ ft. after _____ hours of pumping

WELL DATA

Well Depth	Casing Diameter (In.)	Casing Length (Ft.)
65'	2"	55'

Type of Casing	Hole Depth	Depth to Static Water Level
PVC	65'	10'

TYPE OF COMPLETION: (Circle One or More): Gravel Packed, Underreamed, Telescoped, (Natural Development), Open Hole, Other (Describe) _____

WELL GROUTED TO A DEPTH OF 10 FEET
Type Grout (circle one): Cement, Bentonite, or Mix

LOG DATA

TYPE OF LOG RUN (Circle One): No Log Run, Electric, Gamma Ray, Density, Sonic, Neutron, Other (Describe) _____

Name of Organization Running Log

GEOLOGIC DATA (Office Use Only)

Surface Elev.	Geologic Unit	Unit Thickness	Depth to Top
Subs. SWL	Date	Analysis	Aquifer Test

Driller's Remarks

SCREEN DATA

Diameter - Inches	Length - Feet	Slot Size - Inches
2"	10'	10

Screen Type	Depth to Bottom - Feet
PVC sch 40	65'

DESCRIPTION OF FORMATIONS ENCOUNTERED	FROM	TO	FORMATIONS (Continued)	FROM	TO
Topsoil	1'	2'			
red clay	2'	10'			
white soapstone	10'	28'			
white sand + pee gravel	28'	65'			
			IF MORE SPACE IS NEEDED, USE BACK		

04-13-98 A09:50 RCVD

telescopes please
and show depths.

GROUND LEVEL

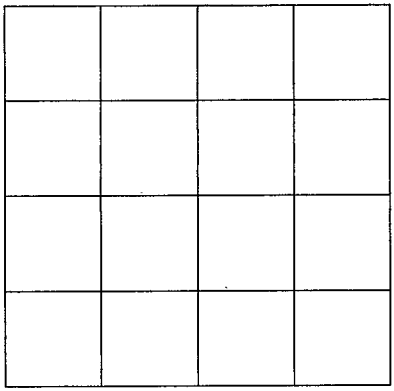

SECTION _____

Please indicate well location X.

ADDITIONAL INFORMATION

If more than one screen,
show location of each on sketch.