MISSISSIPPI DEPARTMENT OF ENVIRONMENTAL QUALITY
Office of Land and Water Resources

P. O. Box 10631
Jackson, MS 39289-0631
WATER WELL DRILLERS LOG

COUNTY WELL LOCATED	Stone
WELL NUMBER	G2133
CODED	
DATE WELL COMPLETED	10-19-99
PERMIT NUMBER	
NAME OF DRILLING FIRM	Moore's Water Well Service
	31 R. Moore Rd, Wiggins

NAME & MAILING ADDRESS OF LANDOWNER
John Wippler
211 Price Rd.
Perkingston, MS

WELL LOCATION: SEC 8 TOWNSHIP 3 S RANGE 11 W

DISTANCE 3 Miles DIRECTION East of NEAREST TOWN Wiggins

OTHER LANDMARK

WELL PURPOSE: Home, Irrigation, Municipal, Industrial, Fish Pond, etc.

PUMP DATA

PUMP TYPE (Circle One): Submersible, Turbine, Jet, Flowing Well, Other (Describe) _____

POWER TYPE (Circle One): Electric, Tractor, Diesel, Gasoline, Butane, Other (Describe) _____ H/P _____

Pump Capacity (GPM)	No. of Stages	Setting Depth
8	2	FT.

PUMP TEST

Well yielded _____ GPM with a drawdown of _____ ft. after _____ hours of pumping

WELL DATA

Well Depth	Casing Diameter (In.)	Casing Length (Ft.)
75'	2"	65'
Type of Casing	**Hole Depth**	**Depth to Static Water Level**
PVC	75'	25'

TYPE OF COMPLETION: (Circle One or More): Gravel Packed, Underreamed, Telescoped, Natural Development, Open Hole, Other (Describe) _____

WELL GROUTED TO A DEPTH OF 10 FEET
Type Grout (circle one): Cement, Bentonite, or Mix

LOG DATA

TYPE OF LOG RUN (Circle One): No Log Run, Electric, Gamma Ray, Density, Sonic, Neutron, Other (Describe) _____

Name of Organization Running Log

GEOLOGIC DATA (Office Use Only)

Surface Elev.	Geologic Unit	Unit Thickness	Depth to Top
Subs. SWL	Date	Analysis	Aquifer Test

Driller's Remarks

Top of Lap Pipe or Reduction in Casing

FEET

IF TELESCOPED OR MORE THAN ONE SCREEN, USE BACK PAGE

SCREEN DATA

Diameter - Inches	Length - Feet	Slot Size - Inches
2"	10'	.08
Screen Type		**Depth to Bottom - Feet**
PVC sch 40		75'

DESCRIPTION OF FORMATIONS ENCOUNTERED	FROM	TO
topsoil	1'	2'
red sandy clay	2'	10'
white soapstone	10'	30'
coarse white sand	30'	75'

FORMATIONS (continued)	FROM	TO

IF MORE SPACE IS NEEDED, USE BACK

If well telescopes please
sketch and show depths.

GROUND LEVEL

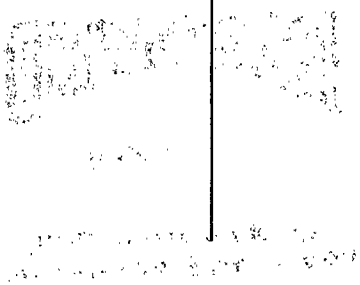

If more than one screen,
show location of each on sketch.

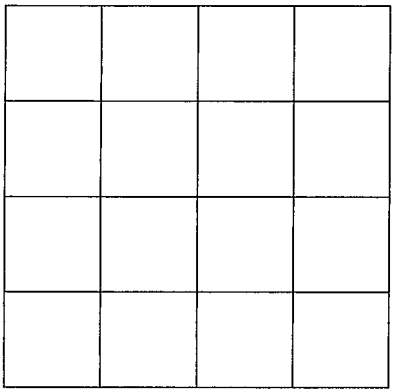

SECTION _____

Please indicate well location X.

ADDITIONAL INFORMATION