MISSISSIPPI DEPARTMENT OF ENVIRONMENTAL QUALITY
Office of Land and Water Resources

P. O. Box 10631
Jackson, MS 39289-0631
WATER WELL DRILLERS LOG

COUNTY WELL LOCATED: Stone	
WELL NUMBER: K-28	CODED:
DATE WELL COMPLETED: 7-29-04	
PERMIT NUMBER:	
NAME OF DRILLING FIRM: Coast Water Well Service	

NAME & MAILING ADDRESS OF LANDOWNER
Desoto Land + Timber
West McHenry Rd 1 of 11
Latitude:
Longitude: Perkinston, MS

WELL LOCATION SEC	TOWNSHIP	RANGE
9	4 N/S	12 E/W

DISTANCE	DIRECTION	NEAREST TOWN
6 Miles	SW of	Perkinston

OTHER LANDMARK

WELL PURPOSE: (Home) Irrigation, Municipal, Industrial, Fish Pond, etc.

WELL DATA

Well Depth	Casing Diameter (In.)	Casing Length (Ft.)
150'	2"	140'

Type of Casing	Hole Depth	Depth to Static Water Level
PVC	150'	50'

TYPE OF COMPLETION: (Circle One or More):
Gravel Packed, Underreamed, Telescoped, (Natural Development), Open Hole, Other (Describe)

WELL GROUTED TO A DEPTH OF 10 FEET
Type Grout (circle one): Cement, (Bentonite), or Mix

SCREEN DATA

Diameter - Inches	Length - Feet	Slot Size - Inches
2"	10'	.008

Screen Type	Depth to Bottom - Feet
PVC	150'

PUMP DATA

PUMP TYPE (Circle One):
Submersible, Turbine, (Jet) Flowing Well,
Other (Describe)

POWER TYPE (Circle One):
(Electric) Tractor, Diesel, Gasoline, Butane,
Other (Describe) H/P 1

DESCRIPTION OF FORMATIONS ENCOUNTERED	FROM	TO
Top Soil	0	2
Orange + Blue Clay	2	130
Brown Coarse Sand	130	150

RECEIVED
AUG 04 2004
BY: OLWF

Top of Lap Pipe or Reduction in Casing
FEET
IF TELESCOPED OR MORE THAN ONE SCREEN: USE BACK PAGE

I certify that the well was drilled, constructed and completed in accordance with all applicable Requirements of the Mississippi Department of Environmental Quality and/or the Mississippi Department of Health regulations and state laws.

Jack Rodwell 472
Signature of Licensed Driller and License No.

7/31/04
Date

Additional Information Required On Back

If well telescopes please sketch and show depths.

GROUND LEVEL

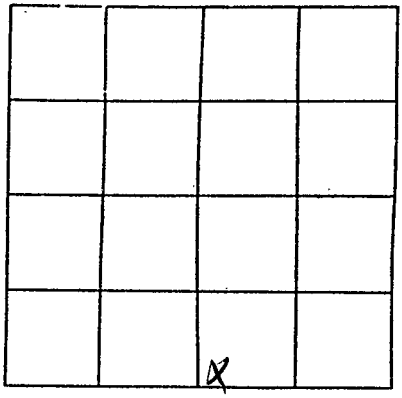

SECTION 9

Please indicate well location X.

Pump Capacity (GPM)	No. of Stages	Setting Depth
7.5	2	FT.

PUMP TEST

Well yielded _____ GPM with

a drawdown of _____ ft.

after _____ hours of pumping

LOG DATA

TYPE OF LOG RUN (Circle One): No Log Run. Electric. Gamma Ray. Density. Sonic. Neutron. Other (Describe) _____

Name of Organization Running Log

GEOLOGIC DATA (Office Use Only)

Surface Elev.	Geologic Unit	Unit Thickness	Depth to Top
Subs. SWL	Date	Analysis	Aquifer Test

Driller's Remarks

If more than one screen, show location of each on sketch.