MISSISSIPPI DEPARTMENT OF ENVIRO

Office of Land and Water R

P. O. Box 10
Jackson, MS 39289-063

WATER WELL DRILLERS LOG

COUNTY WELL LOCATED	Stone
WELL NUMBER	K 2036
CODED	
DATE WELL COMPLETED	7-1-98
PERMIT NUMBER	*
NAME OF DRILLING FIRM	Moores Water Well Serv. 31 R Moore Rd, Wiggins MS.

NAME & MAILING ADDRESS OF LANDOWNER
Rick Herold
38 R. Moran Rd
McHenry MS 39573

WELL LOCATION: SEC	TOWNSHIP	RANGE
8	4 S	12 W

DISTANCE	DIRECTION	NEAREST TOWN
11 Miles	West of	McHenry MS

OTHER LANDMARK

WELL PURPOSE: (Home) Irrigation, Municipal, Industrial, Fish Pond, etc.

PUMP DATA

PUMP TYPE (Circle One): Submersible, Turbine, (Jet) Flowing Well, Other (Describe) _____

POWER TYPE (Circle One): (Electric) Tractor, Diesel, Gasoline, Butane, Other (Describe) _____ H/P _____

Pump Capacity (GPM)	No. of Stages	Setting Depth
6	2	FT.

PUMP TEST

Well yielded _____ GPM with a drawdown of _____ ft. after _____ hours of pumping

WELL DATA

Well Depth	Casing Diameter (In.)	Casing Length (Ft.)
240'	2"	230'

Type of Casing	Hole Depth	Depth to Static Water Level
PVC	240'	58'

TYPE OF COMPLETION: (Circle One or More): (Gravel Packed) Underreamed, Telescoped, Natural Development, Open Hole, Other (Describe) _____

WELL GROUTED TO A DEPTH OF 10 FEET
Type Grout (circle one): Cement, Bentonite, or Mix

LOG DATA

TYPE OF LOG RUN (Circle One): No Log Run, Electric, Gamma Ray, Density, Sonic, Neutron, Other (Describe) _____

Name of Organization Running Log

GEOLOGIC DATA (Office Use Only)

Surface Elev.	Geologic Unit	Unit Thickness	Depth to Top
Subs. SWL	Date	Analysis	Aquifer Test

Driller's Remarks

SCREEN DATA

Diameter - Inches	Length - Feet	Slot Size - Inches
2"	10'	.08

Screen Type	Depth to Bottom - Feet
PVC sch 40	240'

DESCRIPTION OF FORMATIONS ENCOUNTERED	FROM	TO	FORMATIONS (Continued)	FROM	TO
topsoil	1'	2'			
red sandy Clay	2'	18'			
White soapstone	18'	43'			
Blue soapstone	43'	210			
Coarse blue sand & gravel	210'	240'			
			07-16-98A09:20	RCVD	
			IF MORE SPACE IS NEEDED, USE BACK		

If well telescopes please sketch and show depths.

GROUND LEVEL

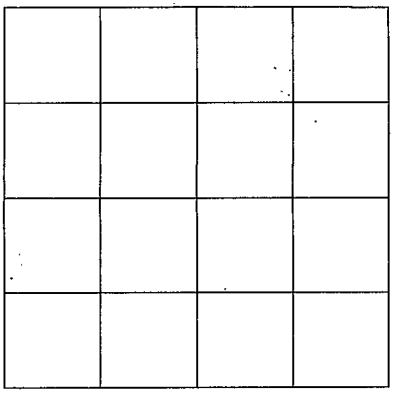

SECTION _____

Please indicate well location X.

ADDITIONAL INFORMATION

If more than one screen, show location of each on sketch.