MISSISSIPPI DEPARTMENT OF ENVIRONMENTAL QUALITY
Office of Land and Water Resources

P. O. Box 10631
Jackson, MS 39289-0631
WATER WELL DRILLERS LOG

COUNTY WELL LOCATED	Stone
WELL NUMBER	K-2030
CODED	
PERMIT NUMBER	
NAME OF DRILLING FIRM	Moores Water Well Service
DATE WELL COMPLETED	10-23-00
	31 R. Moore Rd, Wiggins

NAME & MAILING ADDRESS OF LANDOWNER: Brenda Broadus

Perkinston, MS

WELL LOCATION: SEC 2 TOWNSHIP 4 S RANGE 12 W

DISTANCE 3 Miles DIRECTION West of NEAREST TOWN McHenry

OTHER LANDMARK: go by Ballfield

WELL PURPOSE: Home, Irrigation, Municipal, Industrial, Fish Pond, etc.

PUMP DATA

PUMP TYPE (Circle One): Submersible, Turbine, Jet, Flowing Well, Other (Describe) _____

POWER TYPE (Circle One): Electric, Tractor, Diesel, Gasoline, Butane, Other (Describe) _____ H/P _____

Pump Capacity (GPM)	No. of Stages	Setting Depth
6	2	FT.

PUMP TEST

Well yielded _____ GPM with a drawdown of _____ ft. after _____ hours of pumping

WELL DATA

Well Depth	Casing Diameter (In.)	Casing Length (Ft.)
67'	2"	57'

Type of Casing	Hole Depth	Depth to Static Water Level
PVC	67'	40'

TYPE OF COMPLETION: (Circle One or More): Gravel Packed, Underreamed, Telescoped, Natural Development, Open Hole, Other (Describe) _____

WELL GROUTED TO A DEPTH OF 10 FEET
Type Grout (circle one): Cement, Bentonite, or Mix

LOG DATA

TYPE OF LOG RUN (Circle One): No Log Run, Electric, Gamma Ray, Density, Sonic, Neutron, Other (Describe) _____

Name of Organization Running Log

GEOLOGIC DATA (Office Use Only)

Surface Elev.	Geologic Unit	Unit Thickness	Depth to Top
Subs. SWL	Date	Analysis	Aquifer Test

Driller's Remarks

SCREEN DATA

Diameter - Inches	Length - Feet	Slot Size - Inches
2"	10'	.08

Screen Type	Depth to Bottom - Feet
PVC Sch 40	67'

Top of Lap Pipe or Reduction in Casing FEET (IF TELESCOPED OR MORE THAN ONE SCREEN, USE BACK PAGE)

RECEIVED
NOV 29 2000
Dept. of Environmental Quality
Office of Land & Water Resources

DESCRIPTION OF FORMATIONS ENCOUNTERED	FROM	TO	FORMATIONS (Continued)	FROM	TO
topsoil	1'	2'			
red sandy clay	2'	20'			
white soapstone	20'	47'			
white coarse sand	47'	67'			
			IF MORE SPACE IS NEEDED, USE BACK		

If well telescopes please
sketch and show depths.

GROUND LEVEL

 

If more than one screen,
show location of each on sketch.

SECTION _____

Please indicate well location X.

ADDITIONAL INFORMATION