L 20
Stone
5/1/75

CODED

MISSISSIPPI
BOARD OF WATER COMMISSIONERS
416 North State Street
Jackson, Mississippi 39201

WATER WELL DRILLERS LOG

5-1 1975 Parnell Anderson Stone
date well completed — firm name — county well located

LANDOWNER: Robert Bustin

(mailing address)

WELL LOCATION:
sec. 9 T 4 N/S R 11 E/W
5 miles SE of Perk
(distance) (direction) (nearest town)

WELL PURPOSE: HOME
(home, irrigation, municipal, industrial)

WELL COMPLETION DATA:

(1) diameter (inches) 2"
(2) total depth (feet) 238'
(3) static water level (feet) 130' below ~~above~~ top of ground.
(4) casing Plastic (material), 233' (depth)
_____ (size) if telescope see back.
(5) screen 5', 233' (length), (depth to top)
2" (size), Plastic (material)
(6) pump 1 (HP) 4 (yield gpm)
Elect (type power)
(7) electric log no (yes or no)
(organization running log)
(8) how well bottom plugged Plugged

DRILLERS REMARKS:

description of formations encountered	from	to
Top Soil	0	4
Sandy Clay	4	42
Blue Clay	42	105
Fine Sand	105	125
Blue Clay	125	210
Fine Sand	210	218
Coarse Sand	218	238

RECEIVED
JUN 5 1975
MISS. BD. OF WATER COMM.

If well telescopes please sketch and show depths.

GROUND LEVEL

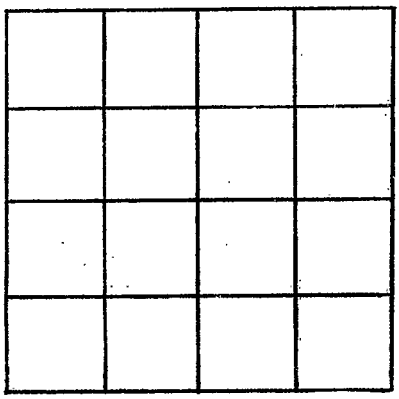

SECTION _____

Please indicate well location X.

ADDITIONAL INFORMATION

If more than one screen, show locations of each on sketch.