

MISSISSIPPI DEPARTMENT OF NATURAL RESOURCES

Bureau of Land and Water Resources

Southport Mall

P.O. Box 10631

Jackson, Mississippi 39209

WATER WELL DRILLERS LOG

STONE  
L 2035


5-21 19 816 Frank Price Stone  
date well completed firm name county well located

LANDOWNER: John Morgan  
description of formations encountered  
from to  
0 3  
Clay 3 195

WELL LOCATION: sec. 8 T. 4 S R. 11 W  
1 miles E of Mc Cormick  
(distance) (direction) (nearest town)  
Lime Sand 195 240  
Coarse Sand 240 285

WELL PURPOSE:  
(home, irrigation, municipal, industrial)

WELL COMPLETION DATA:  
(1) diameter (inches) 2"  
(2) total depth (feet) 285"  
(3) static water level (feet) 180' below top of ground.  
(4) casing PVC, 280' (material) (depth)  
(size) if telescope see back.  
(5) screen 2" / 16, 280' (length) (depth to top)  
(size) (material) PVC  
(6) pump 1 (HP) 8 (yield gpm)  
Elect. (type power)  
(7) electric log NO. (yes or no)  
(organization running log)  
(8) how well bottom plugged B.W.R.

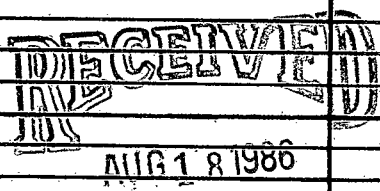


Department of Natural Resources  
Bureau of Land & Water Resources

DRILLERS REMARKS:

If well telescopes please sketch and show depths.

GROUND LEVEL

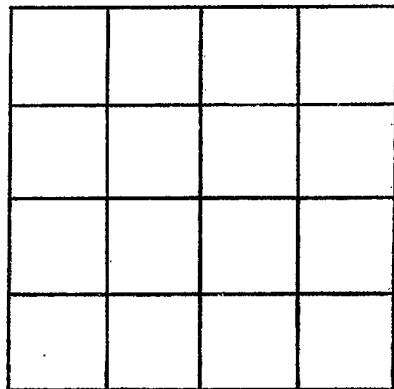

SECTION \_\_\_\_\_

Please indicate well location X.

ADDITIONAL INFORMATION

If more than one screen,  
show locations of each on sketch.