

Sunflower  
B-37  
9-66

MISSISSIPPI BOARD OF WATER COMMISSIONERS

WATER WELL DRILLERS LOG

CODED  
Sunflower  
Washington

Date: 9/6, 1966, Driller: Bailey Drilling Co  
PO Box 5335, Greenville, Miss.

County: Washington

(1) Owner of Land: CV Neel  
(Name)  
Parchman, Miss.  
(Address) 243  
(2) Location: SE 1/4, SE 1/4, Sec. 23 T14R14W  
3 miles E of Parchman  
(distance) (direction) (Nearest Town)  
(3) Topography: Flat  
(Hilly) (Flat) (Level)  
(4) Purpose of Well: Domestic  
(Domestic Irrigation  
Municipal, Industrial, Other)


Description & Color of Materials Sand, Clay, Red Clay, Shell, etc.	Thick- ness Feet	Depth Feet
Clay	0	20
Sand	20	61
Gravel	61	123
Mud	123	266
Sand	266	348
Mud	348	675
Rocks + mud	675	931
Fine sand	931	971
Mud	971	991
Mud + Sand	991	1031
Sand	1031	1082

Information upon completion of well:

(1) Diameter 4 X 2 1/2 X 2 inches  
(2) Total Depth 1080 feet.  
(3) Water Level 1 1/2 ft above feet below top of ground.  
(4) Cased to all way Size 4 X 2 1/2 X 2  
(5) Screen: Size 2", Length 20 ft  
Stainless steel  
(6) Were any formations sealed against pollution?  
\_\_\_\_\_ yes, X no.

4" 126'  
2 1/2" 210'  
2" 724'

CODED

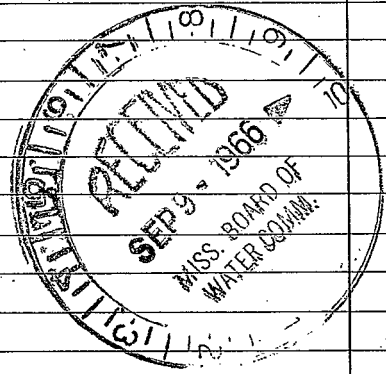

If YES depth of formation \_\_\_\_\_  
Why \_\_\_\_\_  
Drillers Remarks: Pump HP-1  
GPM-15  
Power - Elec

(Use Back Side)

Well No.











