MISSISSIPPI DEPARTMENT OF ENVIRONMENTAL QUALITY
Office of Land and Water Resources

P. O. Box 10631
Jackson, MS 39289-0631
WATER WELL DRILLERS LOG

Drilled

COUNTY WELL LOCATED	Sunflower
WELL NUMBER	C 2014
CODED	
PERMIT NUMBER	
NAME OF DRILLING FIRM	IRRIGATION EQUIPMENT 601/887-2555 INDIANOLA, MS
DATE WELL COMPLETED	3-27-99

NAME & MAILING ADDRESS OF LANDOWNER
WAYNE PARKS
44 Shillings Road
Drew, MS 38737

WELL LOCATION: SEC SW/NW TOWNSHIP 25 RANGE 23 N/S 4 E/W

DISTANCE 3 Miles DIRECTION NW of NEAREST TOWN Drew

OTHER LANDMARK

WELL PURPOSE: Home, Irrigation, Municipal, Industrial, Fish Pond, etc.
Irrigation

PUMP DATA

PUMP TYPE (Circle One): Submersible, Turbine, Jet, Flowing Well, Other (Describe) _____

POWER TYPE (Circle One): Electric, Tractor, Diesel, Gasoline, Butane, Other (Describe) _____ H/P 15

Pump Capacity (GPM)	No. of Stages	Setting Depth
750	1	70 FT.

PUMP TEST

Well yielded _____ GPM with a drawdown of _____ ft. after _____ hours of pumping

WELL DATA

Well Depth	Casing Diameter (In.)	Casing Length (Ft.)
114	10	74

Type of Casing	Hole Depth	Depth to Static Water Level
PVC	114	36 ft.

TYPE OF COMPLETION: (Circle One or More): Gravel Packed, Underreamed, Telescoped, Natural Development, Open Hole, Other (Describe) _____

WELL GROUTED TO A DEPTH OF _____ FEET
Type Grout (circle one): Cement, Bentonite, or Mix

LOG DATA

TYPE OF LOG RUN (Circle One): No Log Run, Electric, Gamma Ray, Density, Sonic, Neutron, Other (Describe) _____

Name of Organization Running Log

GEOLOGIC DATA (Office Use Only)

Surface Elev.	Geologic Unit	Unit Thickness	Depth to Top
Subs. SWL	Date	Analysis	Aquifer Test

Driller's Remarks
Completed 4-12-99

SCREEN DATA

Diameter - Inches	Length - Feet	Slot Size - Inches
10	40	.050

Screen Type	Depth to Bottom - Feet
PVC	114

Top of Lap Pipe or Reduction in Casing
FEET — IF TELESCOPED OR MORE THAN ONE SCREEN: USE BACK PAGE

DESCRIPTION OF FORMATIONS ENCOUNTERED	FROM	TO
Clay	0	28
Fine Sand	28	38
Fine Sand + Gravel	38	45
med. Sand + Gravel	45	55
Fine Sand + Gravel	55	65
med. Sand + Gravel	65	114

FORMATIONS (Continued)	FROM	TO

IF MORE SPACE IS NEEDED, USE BACK

RECEIVED
JUN 07 1999
Dept. of Environmental Quality
Office of Land & Water Resources

If well telescopes please sketch and show depths.

GROUND LEVEL

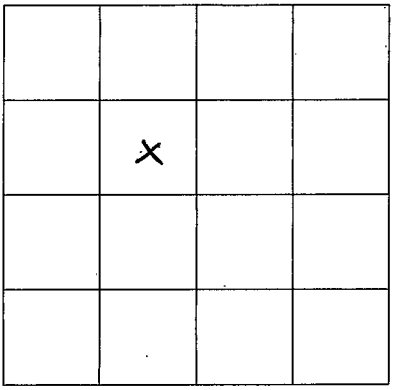

SECTION 25

Please indicate well location X.

ADDITIONAL INFORMATION

If more than one screen, show location of each on sketch.