CODED

SUNFLOWER
D 21
1-16-75

MISSISSIPPI BOARD OF WATER COMMISSIONERS
416 North State Street
Jackson, Mississippi 39201

WATER WELL DRILLERS LOG

Sunflower

January 16, 1975 Dyer-Sullivan ~~Tallahatchie~~
date well completed — firm name — county well located

LANDOWNER: Smith Murphy
P.O. Box 207
Sumner, Miss.
(mailing address)

WELL LOCATION:
sec. 5 T 23 (N) S R 3 E (W) 15H
1 1/2 miles NE of Drew
(distance) (direction) (nearest town)

WELL PURPOSE: Irrigation
(home, irrigation, municipal, industrial)

WELL COMPLETION DATA:

(1) diameter (inches) 16"

(2) total depth (feet) 103

(3) static water level (feet) 12 below above top of ground.

(4) casing Blk Iron (material), 71' (depth),
16" (size) if telescope see back.

(5) screen 40' (length), 71' (depth to top)
16" (size), Blk Iron (material)

(6) pump 60 (HP) 300 (yield gpm)
DIESEL (type power)

(7) electric log No (yes or no)

(organization running log)

(8) how well bottom plugged Plate

DRILLERS REMARKS:

description of formations encountered	from	to
Clay	0	31
Fine Sand	31	71
Sand & Gravel	71	103

RECEIVED
OCT 1 3 1975
MISS. BD. OF WATER COMM.

If well telescopes please sketch and show depths.

GROUND LEVEL

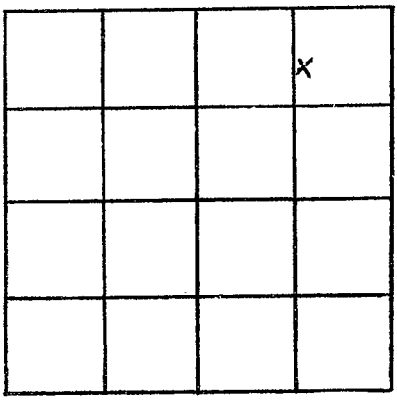

SECTION S

Please indicate well location X.

ADDITIONAL INFORMATION

If more than one screen, show locations of each on sketch.