SUNFLOWER
E 15
9-25-72

MISSISSIPPI
BOARD OF WATER COMMISSIONERS
416 North State Street
Jackson, Mississippi 39201

CODED

# WATER WELL DRILLERS LOG

9/25 1972 Delta Well & Supply Co Sunflower
date well completed — firm name — county well located

LANDOWNER: D. R. Stewart
R. F. Cleveland
(mailing address)

WELL LOCATION:
sec. 18 T 22 N R 4 W
4 miles No East of Cleveland
(distance) (direction) (nearest town)

WELL PURPOSE: Home
(home, irrigation, municipal, industrial)

WELL COMPLETION DATA:
(1) diameter (inches) 4 1/2
(2) total depth (feet) 693
(3) static water level (feet) 32 below above top of ground.
(4) casing Gal Steel, (material) (depth)
(size) if telescope see back.
(5) screen 20 ft, (length) (depth to top)
2" Stainless Steel (size) (material)
(6) pump 1 (HP) 19 (yield gpm)
Elec (type power)
(7) electric log No (yes or no)
(organization running log)
(8) how well bottom plugged B.P. Valve

DRILLERS REMARKS: Z

| description of formations encountered | from | to |
|---|---|---|
| Top Soil | 0 | 23 |
| Sand Fine | 23 | 63 |
| Sand & Gravel | 63 | 160 |
| Shale | 160 | 183 |
| Sand | 183 | 443 |
| Shale | 443 | 483 |
| Clay | 483 | 607 |
| Sand | 607 | 693 |

CODED

SEP 26 1972
MISS. BD. OF WATER COMMS.

If well telescopes please sketch and show depths.

GROUND LEVEL

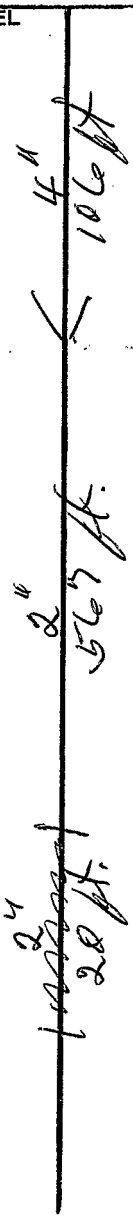


If more than one screen, show locations of each on sketch.

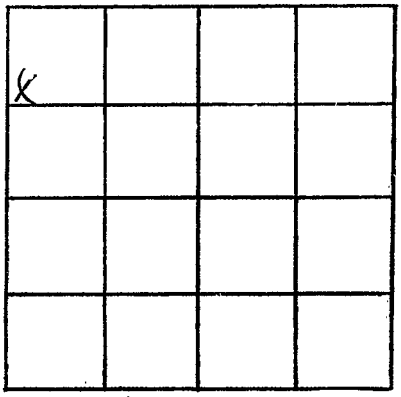


SECTION 18

Please indicate well location X.

ADDITIONAL INFORMATION