MISSISSIPPI DEPARTMENT OF NATURAL RESOURCES

Bureau of Land and Water Resources

P.O. Box 10631
Jackson, Mississippi 39209
WATER WELL DRILLERS LOG

COUNTY WELL LOCATED: Sunflower

WELL NUMBER: E 76 | CODED: ✓

PERMIT NUMBER: 107c of D GW-14155 4

NAME OF DRILLING FIRM: McClains Pump Service

DATE WELL COMPLETED: April 20, 92

NAME & MAILING ADDRESS OF LANDOWNER:
Mrs. Keith P. McLean
Rt 2 Box 212
Cleveland, MS 38732

WELL LOCATION: SEC 33 29 | TOWNSHIP 22 (N) S | RANGE 4 (E) W

DISTANCE ____ Miles DIRECTION ____ of NEAREST TOWN ____

OTHER LANDMARK

WELL PURPOSE: Home, (Irrigation), Municipal, Industrial, Fish Pond, etc.

PUMP DATA

PUMP TYPE (Circle One): Submersible, (Turbine), Jet, Flowing Well, Other (Describe) ____

POWER TYPE (Circle One): Electric, Tractor, (Diesel), Gasoline, Butane, Other (Describe) ____

Pump Capacity (GPM)	No. of Stages	Setting Depth
2500	1	60 FT.

PUMP TEST

Well yielded ____ GPM with a drawdown of ____ ft. after ____ hours of pumping

WELL DATA

Well Depth	Casing Diameter (In.)	Casing Length (Ft.)
110	16	70

Type of Casing	Hole Depth	Depth to Static Water Level
Steel	110	36 ft.

TYPE OF COMPLETION: (Circle One or More): (Gravel Packed), Underreamed, Telescoped, Natural Development, Open Hole, Other (Describe) ____

Top of Lap Pipe or Reduction in Casing ____ FEET

IF TELESCOPED OR MORE THAN ONE SCREEN: USE BACK PAGE

LOG DATA

TYPE OF LOG RUN (Circle One): No Log Run, Electric, Gamma Ray, Density, Sonic, Neutron, Other (Describe) ____

Name of Organization Running Log

GEOLOGIC DATA (Office Use Only)

Surface Elev.	Geologic Unit	Unit Thickness	Depth to Top
Subs. SWL	Date	Analysis	Aquifer Test

Driller's Remarks

RECEIVED
MAY 05 1992

SCREEN DATA

Diameter - Inches	Length - Feet	Slot Size - Inches
16	40	60

Screen Type	Depth to Bottom - Feet
Steel	110

DESCRIPTION OF FORMATIONS ENCOUNTERED	FROM	TO	FORMATIONS (Continued)	FROM	TO
Top Soil	Top	10	Dept. of Environmental Quality		
			Bureau of Land & Water Resources		
Fine Sand	10	30			
Coarse Sand & gravel	30	110			
			IF MORE SPACE IS NEEDED, USE BACK		

If well telescopes please
sketch and show depths.

GROUND LEVEL

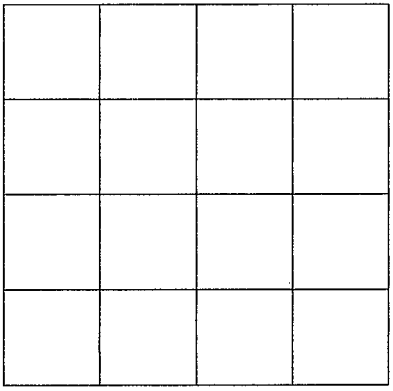

SECTION _____

Please indicate well location X.

ADDITIONAL INFORMATION

If more than one screen,
show location of each on sketch.