22-4006

MISSISSIPPI DEPARTMENT OF NATURAL RESOURCES

Bureau of Land and Water Resources

P.O. Box 10631
Jackson, Mississippi 39209
WATER WELL DRILLERS LOG

COUNTY WELL LOCATED	SUNFLOWER
WELL NUMBER	F92
CODED	✓
DATE WELL COMPLETED	7-8-88
PERMIT NUMBER	
NAME OF DRILLING FIRM	LAYNE-CENTRAL CO.
	PO Box 1378 Cleveland, MS 38732

NAME & MAILING ADDRESS OF LANDOWNER

MINNIE L. MARLOW

P.O. BOX 145

RULEVILLE, MS 38771

WELL LOCATION:	SEC	TOWNSHIP	RANGE
	27	22 N ☒	3 ☒ W

DISTANCE	DIRECTION	NEAREST TOWN
3 Miles	NE of	RULEVILLE

OTHER LANDMARK

WELL PURPOSE: Home, Irrigation, Municipal, Industrial, Fish Pond, etc.
IRRIGATION

PUMP DATA

PUMP TYPE (Circle One):
Submersible, Turbine, Jet Flowing Well,
Other (Describe) NONE INSTALLED

POWER TYPE (Circle One):
Electric, Tractor, Diesel, Gasoline, Butane,
Other (Describe) _____ H/P _____

Pump Capacity (GPM)	No. of Stages	Setting Depth
		FT.

PUMP TEST

Well yielded NOT TESTED GPM with

a drawdown of _____ ft.

after _____ hours of pumping

WELL DATA

Well Depth	Casing Diameter (In.)	Casing Length (Ft.)
114'	16"	64'

Type of Casing	Hole Depth	Depth to Static Water Level
ST.ST.	114'	N/A

TYPE OF COMPLETION: (Circle One or More):
Gravel Packed, Underreamed, Telescoped,
Natural Development, Open Hole, Other
(Describe) _____

Top of Lap Pipe or Reduction in Casing
N/A FEET

IF TELESCOPED OR MORE THAN ONE SCREEN: USE BACK PAGE

LOG DATA

TYPE OF LOG RUN (Circle One): No Log Run,
Electric, Gamma Ray, Density, Sonic, Neutron,
Other (Describe) _____

Name of Organization Running Log

GEOLOGIC DATA (Office Use Only)

Surface Elev.	Geologic Unit	Unit Thickness	Depth to Top
Subs. SWL	Date	Analysis	Aquifer Test

Driller's Remarks

SCREEN DATA

Diameter - Inches	Length - Feet	Slot Size - Inches
16"	50'	.060

Screen Type	Depth to Bottom - Feet
ST.ST.	--

RECEIVED
NOV 30 1988
Department of Natural Resources
Bureau of Land & Water Resources

DESCRIPTION OF FORMATIONS ENCOUNTERED	FROM	TO
sandy clay	0'	22'
fine sand	22'	40'
med. sand	40'	44'
coarse sand & pea gr.	44'	64'
coarse sand	64'	84'
coarse sand & pea gr.	84'	94'
coarse sand & gravel	94'	114'

FORMATIONS (Continued)	FROM	TO

IF MORE SPACE IS NEEDED, USE BACK

If well telescopes please
sketch and show depths.

GROUND LEVEL

 

If more than one screen,
show location of each on sketch.

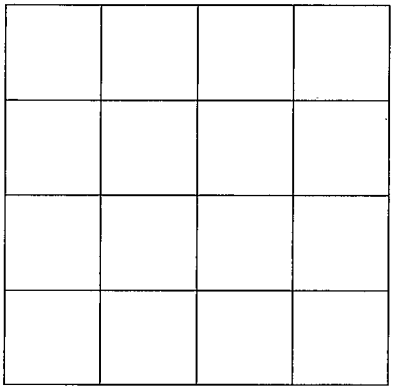

SECTION _____

Please indicate well location X.

ADDITIONAL INFORMATION