SUNFLOWER
G 2000
12-9-80

MISSISSIPPI
BOARD OF WATER COMMISSIONERS
416 North State Street
Jackson, Mississippi 39201

WATER WELL DRILLERS LOG

12/9/ 1980 BUTANE GAS COMPANY OF GREENWOOD — Sunflower
date well completed — firm owned — county well located

LANDOWNER: W.T. Lehr
Cleveland
(mailing address)

WELL LOCATION:
sec. 3 T 21 N S R 4 E W
2½ miles SW (direction) of Ruleville (nearest town)
(distance)

WELL PURPOSE: None
(home, irrigation, municipal, industrial)

WELL COMPLETION DATA:

(1) diameter (inches) 4 x 2
(2) total depth (feet) 693
(3) static water level (feet) 38 below ~~above~~ top of ground.
(4) casing Steel (material), 673 (depth), 4 x 2 (size) if telescope see back.
(5) screen 20 (length), 673 (depth to top)
2" (size), Stainless (material)
(6) pump 1 (HP) 20 (yield gpm)
Elec (type power)
(7) electric log No (yes or no)
(organization running log)
(8) how well bottom plugged Back Pressure Valve

DRILLERS REMARKS:

description of formations encountered	from	to
Clay	0	20
Sand	20	100
Sand & Clay	100	420
Sand	420	600
Sand & Shale	600	640
Coarse Sand	640	698

DEPT. OF NATURAL RESOURCES
BUREAU OF LAND & WATER RESOURCES
DEC 12 1980
RECEIVED

If well telescopes please sketch and show depths.

GROUND LEVEL

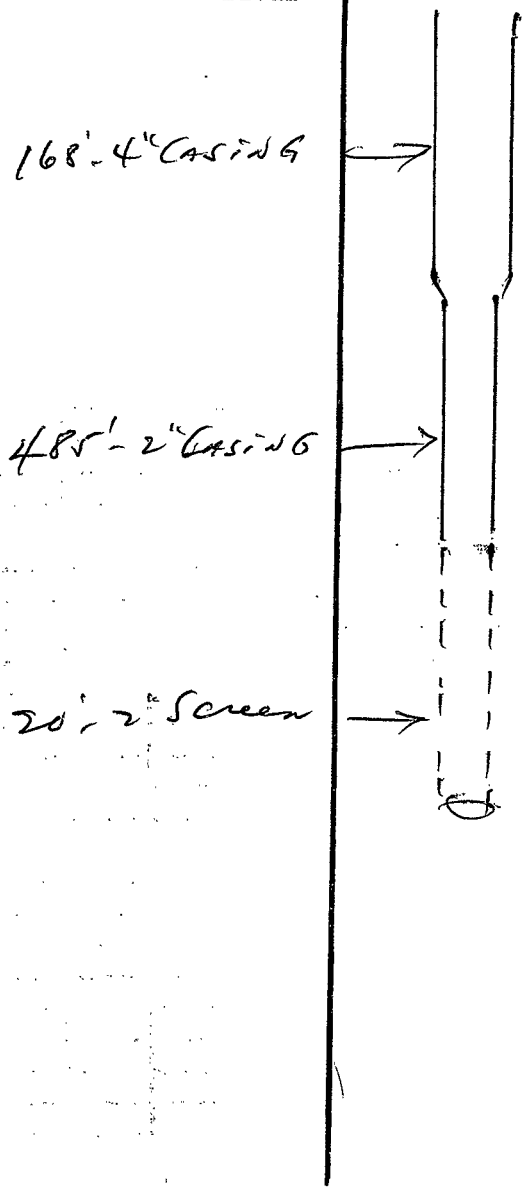

If more than one screen, show locations of each on sketch.

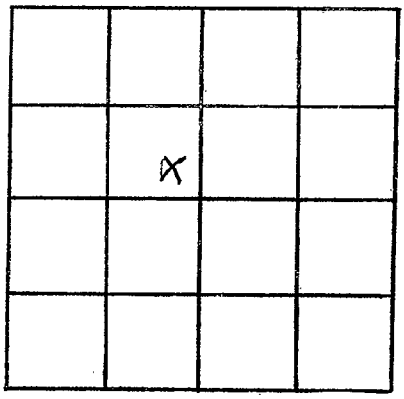

SECTION 3

Please indicate well location X.

ADDITIONAL INFORMATION