MISSISSIPPI DEPARTMENT OF ENVIRONMENTAL QUALITY
Office of Land and Water Resources

P. O. Box 10631
Jackson, MS 39289-0631
WATER WELL DRILLERS LOG

COUNTY WELL LOCATED	Sunflower
WELL NUMBER	G 2030
CODED	
DATE WELL COMPLETED	3-24-98
PERMIT NUMBER	
NAME OF DRILLING FIRM	IRRIGATION EQUIPMENT 601/887-2555 INDIANOLA, MS

NAME & MAILING ADDRESS OF LANDOWNER
William FIANAGAN
101 Mitchell Road
SHAW, MS 38773

WELL LOCATION: SEC NE/NW TOWNSHIP 28 21 RANGE 4 (N) S (E) W

DISTANCE 1 Miles DIRECTION South of NEAREST TOWN LINN

OTHER LANDMARK

WELL PURPOSE: Home, Irrigation, Municipal, Industrial, Fish Pond, etc.
IRRIGATION

PUMP DATA

PUMP TYPE (Circle One): Submersible, Turbine, Jet, Flowing Well, Other (Describe) _____

POWER TYPE (Circle One): Electric, Tractor, Diesel, Gasoline, Butane, Other (Describe) _____ H/P 10

Pump Capacity (GPM)	No. of Stages	Setting Depth
500	1	60 FT.

PUMP TEST

Well yielded _____ GPM with a drawdown of _____ ft. after _____ hours of pumping

WELL DATA

Well Depth	Casing Diameter (In.)	Casing Length (Ft.)
117	10	77

Type of Casing	Hole Depth	Depth to Static Water Level
PVC	117	46 Ft.

TYPE OF COMPLETION: (Circle One or More): Gravel Packed, Underreamed, Telescoped, Natural Development, Open Hole, Other (Describe) _____

WELL GROUTED TO A DEPTH OF _____ FEET
Type Grout (circle one): Cement, Bentonite, or Mix

LOG DATA

TYPE OF LOG RUN (Circle One): No Log Run, Electric, Gamma Ray, Density, Sonic, Neutron, Other (Describe) _____

Name of Organization Running Log

GEOLOGIC DATA (Office Use Only)

Surface Elev.	Geologic Unit	Unit Thickness	Depth to Top
Subs. SWL	Date	Analysis	Aquifer Test

Driller's Remarks

SCREEN DATA

Diameter - Inches	Length - Feet	Slot Size - Inches
10	40	.050

Screen Type	Depth to Bottom - Feet
PVC	117

Top of Lap Pipe or Reduction in Casing
FEET

IF TELESCOPED OR MORE THAN ONE SCREEN: USE BACK PAGE

DESCRIPTION OF FORMATIONS ENCOUNTERED	FROM	TO	FORMATIONS (Continued)	FROM	TO
Clay	0	39			
Fine Sand	39	45			
Fine Sand + Gravel	45	70			
Med. Sand + Gravel	70	117			
			04-08-98A09:38 RCVD		
			IF MORE SPACE IS NEEDED, USE BACK		

If well telescopes please sketch and show depths.

GROUND LEVEL

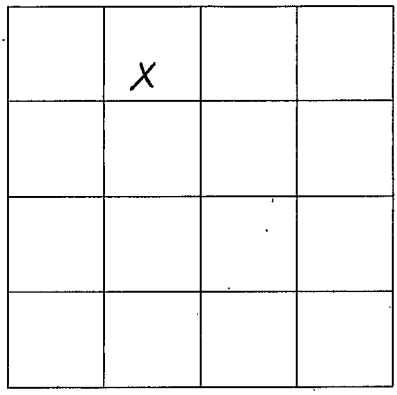

SECTION 28

Please indicate well location X.

ADDITIONAL INFORMATION

If more than one screen, show location of each on sketch.