SUNFLOWER

MISSISSIPPI DEPARTMENT OF ENVIRONMENTAL QUALITY
Office of Land and Water Resources

P. O. Box 10631
Jackson, MS 39289-0631

WATER WELL DRILLERS LOG

COUNTY WELL LOCATED	~~BOLIVAR~~
WELL NUMBER	G 2033
CODED	
DATE WELL COMPLETED	6/15/98
PERMIT NUMBER	
NAME OF DRILLING FIRM	LAYNE-CENTRAL, a division of Layne Christensen Company

NAME & MAILING ADDRESS OF LANDOWNER
WARNOCK FARMS
P.O. DRAWER 1680
CLEVELAND, MS 38732

WELL LOCATION:	SEC	TOWNSHIP	RANGE
	4	21 N	4 W

DISTANCE	DIRECTION	NEAREST TOWN
1½ Miles	SOUTH of	DOCKERY

OTHER LANDMARK

WELL PURPOSE: Home, Irrigation, Municipal, Industrial, Fish Pond, etc.
IRRIGATION

PUMP DATA

PUMP TYPE (Circle One): PUMP BY CUSTOMER
Submersible, Turbine, Jet Flowing Well, Other (Describe) _____

POWER TYPE (Circle One):
Electric, Tractor, Diesel, Gasoline, Butane, Other (Describe) _____ H/P _____

Pump Capacity (GPM)	No. of Stages	Setting Depth
		FT.

PUMP TEST
Well yielded NOT TESTED GPM with a drawdown of _____ ft. after _____ hours of pumping

WELL DATA

Well Depth	Casing Diameter (In.)	Casing Length (Ft.)
118'	16"	78'

Type of Casing	Hole Depth	Depth to Static Water Level
PVC	118'	NOT CHECKED

TYPE OF COMPLETION: (Circle One or More):
Gravel Packed, Underreamed, Telescoped, Natural Development, Open Hole, Other (Describe) _____

WELL GROUTED TO A DEPTH OF 10 FEET
Type Grout (circle one): Cement, Bentonite, or Mix

LOG DATA

TYPE OF LOG RUN (Circle One): No Log Run,
Electric, Gamma Ray, Density, Sonic, Neutron, Other (Describe) _____

Name of Organization Running Log

GEOLOGIC DATA (Office Use Only)

Surface Elev.	Geologic Unit	Unit Thickness	Depth to Top
Subs. SWL	Date	Analysis	Aquifer Test

Driller's Remarks
07-22-98A09:20 RCVD

Top of Lap Pipe or Reduction in Casing
FEET — IF TELESCOPED OR MORE THAN ONE SCREEN: USE BACK PAGE

SCREEN DATA

Diameter - Inches	Length - Feet	Slot Size - Inches
16"	40'	.050

Screen Type	Depth to Bottom - Feet
PVC	118'

DESCRIPTION OF FORMATIONS ENCOUNTERED	FROM	TO	FORMATIONS (Continued)	FROM	TO
CLAY, FINE SAND	0	13			
FINE SAND	13	23			
FINE SAND, CLAY	23	33			
FINE SAND	33	43			
CLAY, COARSE SAND	43	53			
COARSE SAND	53	98			
COARSE SAND, PEA GRAV	98	118			
			IF MORE SPACE IS NEEDED, USE BACK		

If well telescopes please
sketch and show depths.

GROUND LEVEL

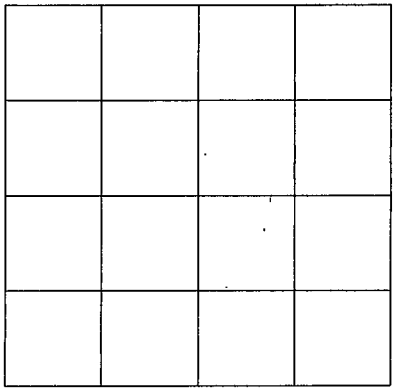

SECTION _____

Please indicate well location X.

ADDITIONAL INFORMATION

If more than one screen,
show location of each on sketch.