MISSISSIPPI DEPARTMENT OF ENVIRONMENTAL QUALITY
Office of Land and Water Resources
P. O. Box 10631
Jackson, MS 39289-0631
WATER WELL DRILLERS LOG

COUNTY WELL LOCATED	SUNFLOWER
WELL NUMBER	A 2019
CODED	
PERMIT NUMBER	
NAME OF DRILLING FIRM	LAYNE-CENTRAL, a division of Layne Christensen Company
DATE WELL COMPLETED	5/19/97

NAME & MAILING ADDRESS OF LANDOWNER
LUBIN FARMS PARTNERSHIP
ROUTE 1, BOX 538
DODDSVILLE, MS 38736

WELL LOCATION:	SEC	TOWNSHIP	RANGE
	36	21 N	3 W

DISTANCE	DIRECTION	NEAREST TOWN
4 Miles	E of	DODDSVILLE

OTHER LANDMARK

WELL PURPOSE: Home, Irrigation, Municipal, Industrial, Fish Pond, etc.

PUMP DATA

PUMP TYPE (Circle One): Submersible, Turbine, Jet, Flowing Well, Other (Describe)

POWER TYPE (Circle One): Electric, Tractor, Diesel, Gasoline, Butane, Other (Describe) H/P

Pump Capacity (GPM)	No. of Stages	Setting Depth
2500	1	60 FT.

PUMP TEST

Well yielded NOT TESTED GPM with a drawdown of ft. after hours of pumping

WELL DATA

Well Depth	Casing Diameter (In.)	Casing Length (Ft.)
120'	16"	80'

Type of Casing	Hole Depth	Depth to Static Water Level
PVC	120'	46'

TYPE OF COMPLETION: (Circle One or More): Gravel Packed, Underreamed, Telescoped, Natural Development, Open Hole, Other (Describe)

WELL GROUTED TO A DEPTH OF 10 FEET
Type Grout (circle one): Cement, Bentonite, or Mix

LOG DATA

TYPE OF LOG RUN (Circle One): No Log Run, Electric, Gamma Ray, Density, Sonic, Neutron, Other (Describe)

Name of Organization Running Log

GEOLOGIC DATA (Office Use Only)

Surface Elev.	Geologic Unit	Unit Thickness	Depth to Top
Subs. SWL	Date	Analysis	Aquifer Test

Driller's Remarks

Top of Lap Pipe or Reduction in Casing
FEET — IF TELESCOPED OR MORE THAN ONE SCREEN: USE BACK PAGE

SCREEN DATA

Diameter - Inches	Length - Feet	Slot Size - Inches
16"	40'	.050

Screen Type	Depth to Bottom - Feet
PVC	120'

DESCRIPTION OF FORMATIONS ENCOUNTERED	FROM	TO
CLAY	0	13
CLAY	13	23
CLAY	23	33
COARSE SAND	33	43
COARSE SAND, PEA GRAV	43	53
COARSE SAND, PEA GRAV	53	120

FORMATIONS (Continued)	FROM	TO

RECEIVED
JUN 13 1997
Dept. of Environmental Quality
Office of Land & Water Resources

IF MORE SPACE IS NEEDED, USE BACK

If well telescopes please
sketch and show depths.

GROUND LEVEL

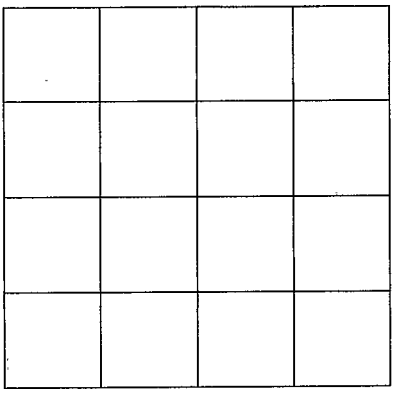

SECTION _____

Please indicate well location X.

ADDITIONAL INFORMATION

If more than one screen,
show location of each on sketch.