Sunflower
J 23
10-67

MISSISSIPPI
BOARD OF WATER COMMISSIONERS
416 North State Street
Jackson, Mississippi 39201

WATER WELL DRILLERS LOG

Oct 17 1967 Butane Gas of Sunflower
date well completed — firm name Greenville — county well located

LANDOWNER: Well #3
Vince Muzzi
Shaw, Miss
(mailing address)

WELL LOCATION:
sec. 9 T 20 N ~~S~~ R 5 E ~~W~~
3 miles E of Shaw
(distance) (direction) (nearest town)

WELL PURPOSE: Home
(home, irrigation, municipal, industrial)

WELL COMPLETION DATA:

(1) diameter (inches) 4" x 2"
(2) total depth (feet) 1580'
(3) static water level (feet) _____ ~~below~~ above top of ground.
(4) casing 4" – 105' / 2" – 1450', (material) (depth)
4x2 (size) If telescope see back.
(5) screen 20', 1555' (length) (depth to top)
2", Stainless Steel (size) (material)
(6) pump 1 (HP) 10 (yield gpm)
Electric (type power)
(7) electric log No (yes or no)
(organization running log)
(8) how well bottom plugged
Back Pressure Valve

DRILLERS REMARKS:

description of formations encountered	from	to
SAND	1542	1583

RECEIVED NOV 20 1967 MISS. BOARD OF WATER COMM.

If well telescopes please sketch and show depths.

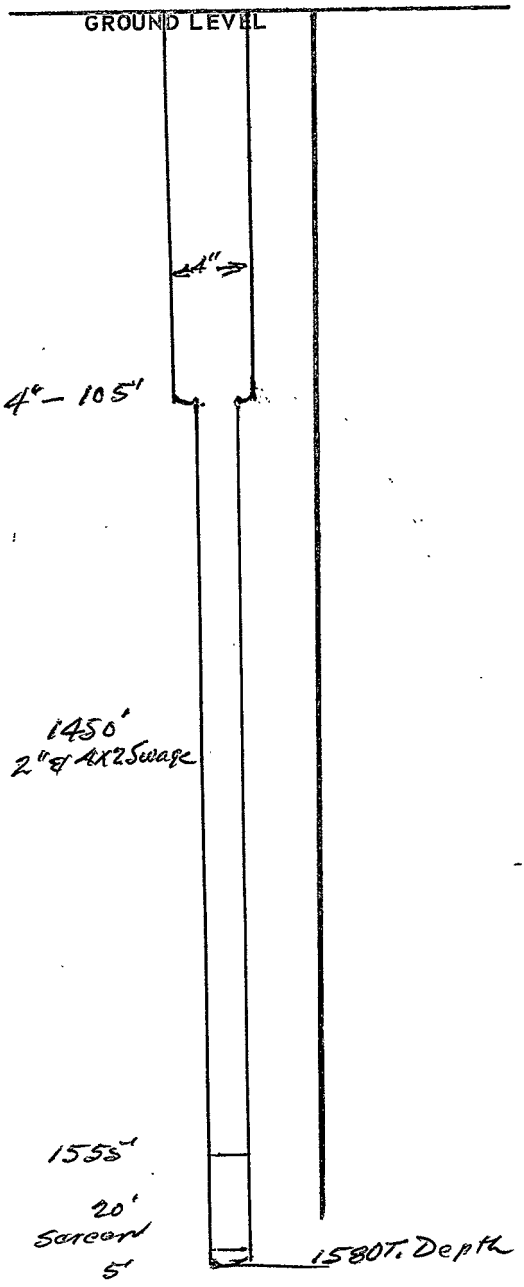

If more than one screen, show locations of each on sketch.

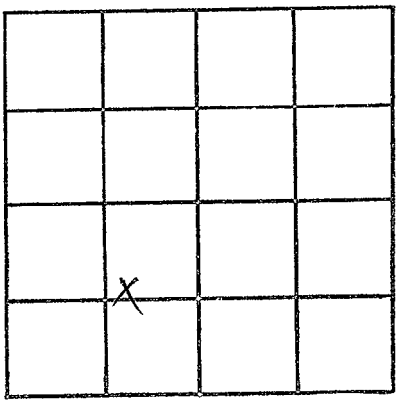

SECTION 9

Please indicate well location X.

ADDITIONAL INFORMATION