CODED

Sunflower
I 24
8-67
Elec Log

MISSISSIPPI
BOARD OF WATER COMMISSIONERS
416 North State Street
Jackson, Mississippi 39201

WATER WELL DRILLERS LOG

Aug 7, 67 19 — Butane Gas of Greenwood — Sunflower
date well completed — firm name — county well located

LANDOWNER: Vince Muzzi

Shaw, Miss
(mailing address)

WELL LOCATION:
sec. 9 T. 20 N (S) R. 5 E (W)

3 miles (distance) E (direction) of Shaw (nearest town)

WELL PURPOSE: Home
(home, irrigation, municipal, industrial)

WELL COMPLETION DATA:

(1) diameter (inches) 4" x 2"

(2) total depth (feet) 975'

(3) static water level (feet) 18 below ~~above~~ top of ground.

(4) casing 4" - 105' (material), 2" - 950' (depth),
4" & 2" (size) if telescope see back.

(5) screen 20' (length), 955' (depth to top)
2" (size), Stainless Steel (material)

(6) pump 1 (HP) 106 gpm (yield gpm)
Electric (type power)

(7) electric log Yes (yes or no)
Miss. Geol. Survey (organization running log)

(8) how well bottom plugged
Back Pressure Valve

DRILLERS REMARKS:

description of formations encountered	from	to
Elev. 125' Topo		
Medium Grey Sand	950	980

RECEIVED
AUG 10 1967
MISS. BOARD OF WATER COMM.

If well telescopes please sketch and show depths.

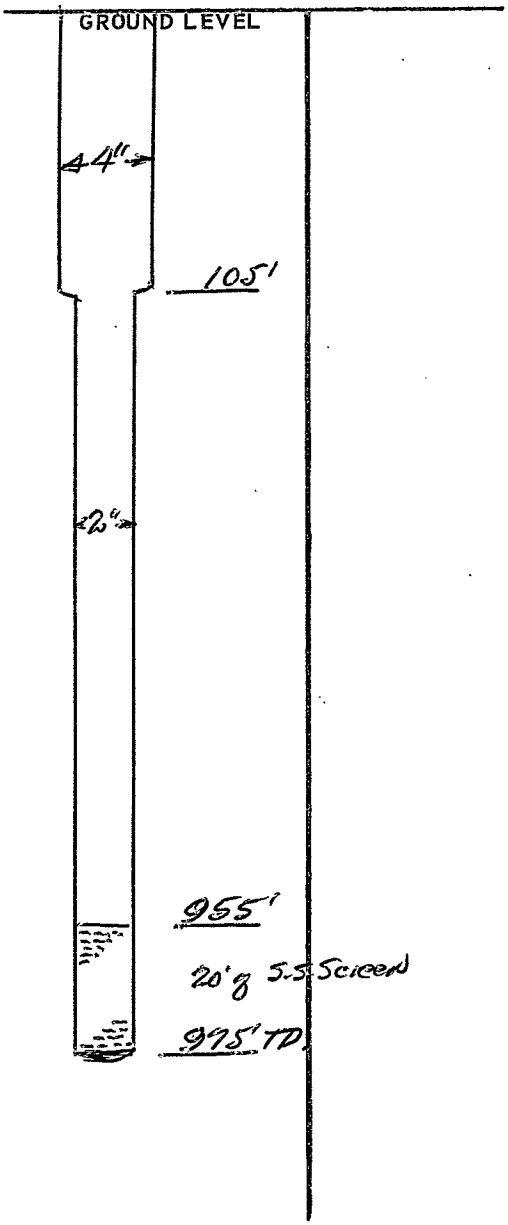

If more than one screen, show locations of each on sketch.

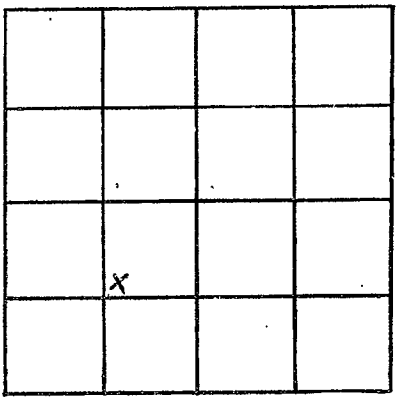

SECTION 9

Please indicate well location X.

ADDITIONAL INFORMATION