Sunflower
J 38
4-3-80

MISSISSIPPI
BOARD OF WATER COMMISSIONERS
416 North State Street
Jackson, Mississippi 39201

WATER WELL DRILLERS LOG

CODED
Sunflower

4/3/80 19
date well completed

Dyer
firm name

Bolivar
county well located

LANDOWNER:
VINCE MUZZI
Shaw MS.
(mailing address)

WELL LOCATION:
sec. 4 T 20 N (S) R 5 E (W)
6 miles 13 of Shaw
(distance) (direction) (nearest town)

WELL PURPOSE:
(home, irrigation, municipal, industrial)

WELL COMPLETION DATA:

(1) diameter (inches) 12"
(2) total depth (feet) 103'
(3) static water level (feet) 22' below above top of ground.
(4) casing Steel (material), 103' (depth), 12" (size) if telescope see back.
(5) screen 40' (length), 63' (depth to top), 12" (size), Steel (material)
(6) pump 40 (HP) 2000 (yield gpm) diesel (type power)
(7) electric log _____ (yes or no)
_____ (organization running log)
(8) how well bottom plugged plate

DRILLERS REMARKS:

description of formations encountered	from	to
Clay	0	28
Fine Sand	28	38
Sand	38	49
Sand & Gravel	49	103

CODED

MAY 1987 RECEIVED

If well telescopes please sketch and show depths.

GROUND LEVEL

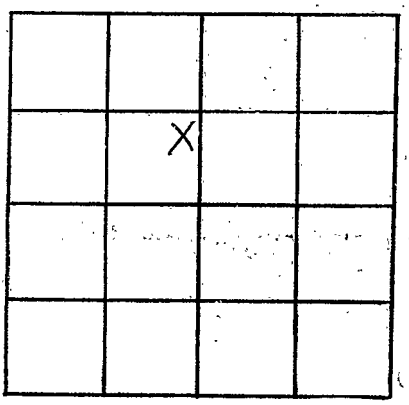

SECTION 11

Please indicate well location X.

ADDITIONAL INFORMATION

If more than one screen, show locations of each on sketch.